


Section 2 Township 17 Range 4 E

Well No. #1 Uker

Company Franco Central

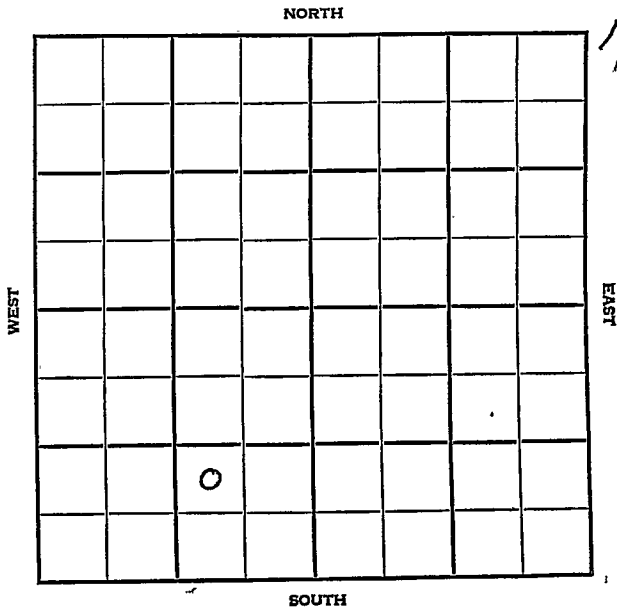

Marion

KANSAS

SEC. 2	TWP. 17	R. 4E
-----------	------------	----------

WELL NO.

#4 Uker

FARM

COMPANY

Franco Central

CONTRACTOR

White-Ellis

Lost Springs


Ft. from N. Line

Ft. from S. Line

Ft. from E. Line

Ft. from W. Line

NW SE SW

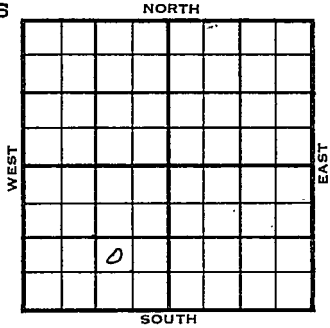

1956	ELEVATION 1452	REPORT
------	-------------------	--------

2-29 8" @ 124

3-21 5½" @ 2337/100
 DD 2352
 FU 100' oil, 60' wtr. 8 hrs., frac
 Comp. 25 bopd, 60% wtr.
 M. 2316
 TD 2338

COMPLETED

County Marton Elev. 1152
 Sec. 2 Twp. 17 Rge. 1E
 Company Franco Central
 Farm Name Ukey No. 4

TOPS	DEPTH	LOG	DATUM	Loc. in Sec.
Anh.				NW SE SW
Tp.				
H.				
Tr.				
Dg.				
Bl.				
L.				
K.C.				Geol.
B.K.C.				Contr.
Ce.				White & Ellis
C.				
M.				Pool
M.				Lost Springs
K.				
Mz.				
Mq.				
V.				
S.				
S.				
A.				
R.				
PE.				
G.				
T.D.				

FIRST REPORT
 FEB 29 '56
 0

Date Comm. 8th @ 12h



Co.
 No.
 Sec.
 T.
 R.

MAR 7 1956

R. G.

County Marion Elev. 1152
 Sec. 2 Twp. 17 Rge. 4E
 Company Franco Central
 FarmName Uker No. 4

TOPS	DEPTH	LOG	DATUM	Loc. in Sec.	
Anh.				NW SE SW	
TP.	
H.	
Tr.	
Dg.	
Bl.	
L.				Geol.	
K.C.				Contr.	
B.K.C.				White & Ellis	
Ce.				Pool	
C.				Lost Springs	
M.	<u>2316</u>		<u>864</u>	<table border="1"> <tr><td></td><td></td><td></td><td></td></tr> <tr><td></td><td></td><td></td><td></td></tr> <tr><td></td><td></td><td></td><td></td></tr> <tr><td></td><td></td><td></td><td></td></tr> <tr><td></td><td></td><td></td><td></td></tr> <tr><td></td><td></td><td></td><td></td></tr> <tr><td></td><td></td><td></td><td></td></tr> <tr><td></td><td></td><td></td><td></td></tr> <tr><td></td><td></td><td></td><td></td></tr> <tr><td></td><td></td><td></td><td></td></tr> </table>	
M.	
K.	
Mz.	
Me.	
V.	
S.	
S.	
A.	
R.	
PE.	
G.	
T.D.	<u>2338</u>	

Date Comm. MAR 2 1 1956
8" @ 121 5 1/2" @ 2337/100 DD2352
FU 100' oil 60' wtr. 8 hr. frac
Comp. 25 bopd 60% wtr.

Co.
 No.
 Sec.
 T.
 R.

APR 2 1956

R. G.