


Section 2 Township 17 Range 5E

Well No. #1 Hurd

Company Kaester & Mergen

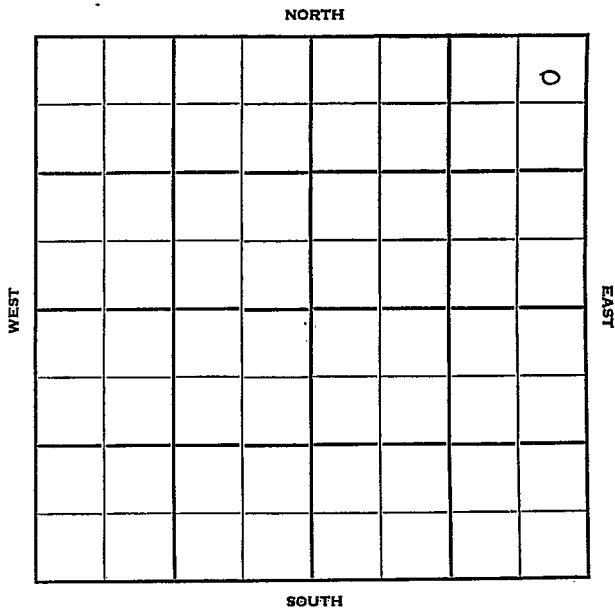

Morris

KANSAS

Sec. 2 Twp. 17 R. 5E

Well No. #1 Hurd Farm

Kaester & Mergen Company

Slusser Contractor

3 Mile Creek


330 Ft. from N. Line

_____ Ft. from S. Line

330 Ft. from E. Line

_____ Ft. from W. Line

NE NE NE

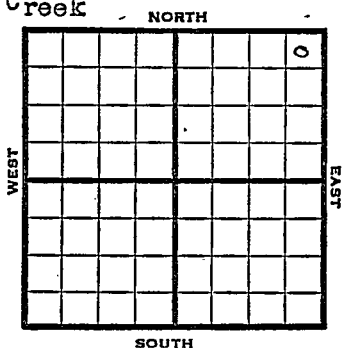

1952 Elev. 1443' REPORT

- 1/23 Location
- 2/6 "
- 2/13 8" @ 150'
Drilling
- 2/20 Miss Chert 2191-95 TD NS
5" @ 2191' WOC
- 3/12 - Spud 1-30-52
Oil Well TD 2247
8" @ 150
Miss 2191-95 5" @ 2195
DD 2216 FU 275' wtr 12 hr.
DD 2236 FU 775 wtr 200' oil 12 hr.
DD 2242 Hydra S/4 bo & wtr 6 hr.
DD 2247 Comp. 15 bopd 30 bw

COMPLETED

County Morris State Kansas

Sec. 2 (Blk. Twp.) 17 (Sur. Rge.) 5E Map No.

Operator Kaester & Mergen

Well No. 1 Farm Hurd

Elev. _____ Location NE NE NE

| | | | | | | | | | |
|--|--|--|--|--|--|--|--|--|--|
| | | | | | | | | | |
| | | | | | | | | | |
330 Ft. From N Line NE

330 Ft. From E Line Quarter

1st. Report JAN 23 1952

Completion _____

Remarks _____

Slusser - Contr.

Spudding Date _____

FIRST REPORT

Drlg. Data 3 Mile Creek

J. E. TYRA

County Morris State _____

Sec. 2 (Blk. Twp.) 17 (Sur. Rge.) 5E Map No. _____

Operator Koester & Mergen

Well No. 1 Farm Hurd

Elev. 1443 Location NE NE NE

| | | | | | | | | | |
|--|--|--|--|--|--|--|--|--|--|
| | | | | | | | | | |
| | | | | | | | | | |
330 Ft. From N Line NE

330 Ft. From E Line Quarter

1st. Report _____

Completion MAR 1 1952

Remarks 3 Mile Creek

Slusser - Contr.

Spudding Date 1-30-52

Drlg. Data Oil well TD 2247

8" @ 150 Miss. 2191-95 5" @ 2195

DD 2216 FU 275' water 12 hr. DD 2236

FU 775' water 200' oil 12 hr.

DD 2242 Hydro. S/ 4 bo & water 6 hr.

DD 2247 Comp. 15 bopd: .30 bw