
Marion KANSAS

SECTION 2 TOWNSHIP 17 RANGE 4 E

WELL NO. #5 Martin

COMPANY Irwin Daetwiler

3

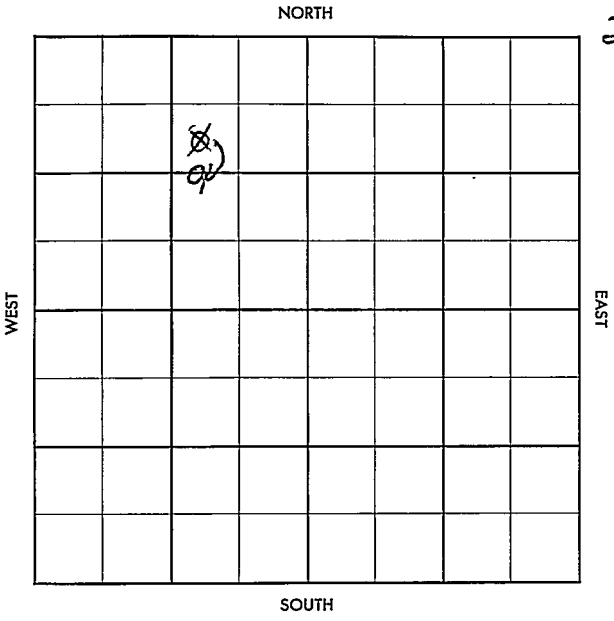

FORM 504-3 SUNRAY

Marion KANSAS

SEC.	TWP.	R.
2	17	4E

WELL NO. 5
#5 Martin FARM
COMPANY

Irwin Daetwiler
CONTRACTOR

Augusta

Lost Springs


_____ Ft. from N. Line

_____ Ft. from S. Line

_____ Ft. from E. Line

_____ Ft. from W. Line

~~SW NE NW~~
C W½ E½ NW

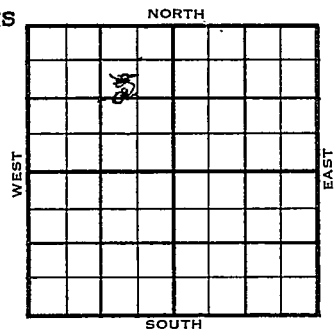

1955	ELEVATION REPORT
11-30	Comm.11-23-55 8" @ 85/75 Drlg. 2080 Anh. K.C. 1719
12-28	5½" @ 2277 DD 2297 S/ 4 boph, 1000 A P/ 80 bopd 10% wtr. Cpmp. 25 bopd 10% wtr. TD 2277'

COMPLETED

DX-78

FORM 513 REV. SUNRAY

County Marion Elev.

Sec. 2 Twp. 17 Rge. 1E

Company Irvin Daetwiler

Farm Name Martin No. 6


TOPS	DEPTH	LOG	DATUM
Anh.			
Tp.			
H.			
Tr.			
Dg.			
B.L.			
L.			
K.C.	1719		
B.K.C.			
Ce.			
C.			
M.			
M.			
K.			
Mz.			
Mo.			
V.			
S.			
S.			
A			
R.			
P€.			
G.			
T.D.			

Loc. in Sec. SW NE NW

Geol.

Contr. Augusta

Pool Lost Springs

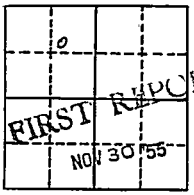

Date Comm. 11-23-55

8" @ 85/75 drlg. 2080

Co. Lse. No. Sec. T. R.

SCOUT TICKET DX-201

SEC.	TWP.	R.
2	17	4E

WELL NO.

5 Martin FARM

COMPANY

Irwin Daetwiler

CONTRACTOR

CORRECTION


C W½ E½ NW.

_____ FT. FROM N. LINE

1320 FT. FROM S. LINE

990 FT. FORM E. LINE

_____ FT. FROM W. LINE

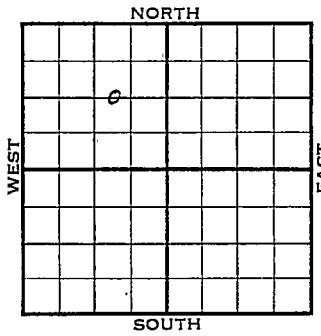

Marion County

☐ LOCATION

☐ RIG UP

DRILLING AND REMARKS:

Reported
SW NE NW

D.A

RECORD

CASED IN., FT.

SAND

GAS

OIL

TOTAL DEPTH

PRODUCTION

1ST 24 HRS. NAT.

1ST 24 HRS. AFTER SHOT

GAS CU. FT.

DRY HOLE

ABANDONED

DATE

DEC 2 8 1955

SCOUT

FORM 513 REV. SUNRAY

County Marion Elev.

Sec. 2 Twp. 17 Rge. 4E

Company Irwin Daetwiler

Farm Name Martin No. 5

TOPS	DEPTH	LOG	DATUM
Anh.			
Tp.			
H.			
Tr.			
Dg.			
Bl.			
L.			
K.C.	1719		
B.K.C.			
Ce.			
C.			
M.	2276		
M.			
K.			
Mz.			
Mq.			
V.			
S.			
S.			
A			
R.			
P€.			
G.			
T.D.	2277		

Loc. in Sec. C W½ E½ NW

Geol.

Contr. Augusta

Pool Lost Springs

COMPLETE

Date Comm. 11-23-55 DEC 28 1955

8" @ 85/75 5½" @ 2277 DD 2297

S/ 4 boph 1000 A P/ 80 bopd

10% wtr. Comp. 25 bopd 10% w tr.

Co. Lse. No. Sec. T. R.