


Marion

KANSAS

Section 2 Township 17 Range 4 E

Well No. # 1 Martin

Company Irvin Daetwiler et al

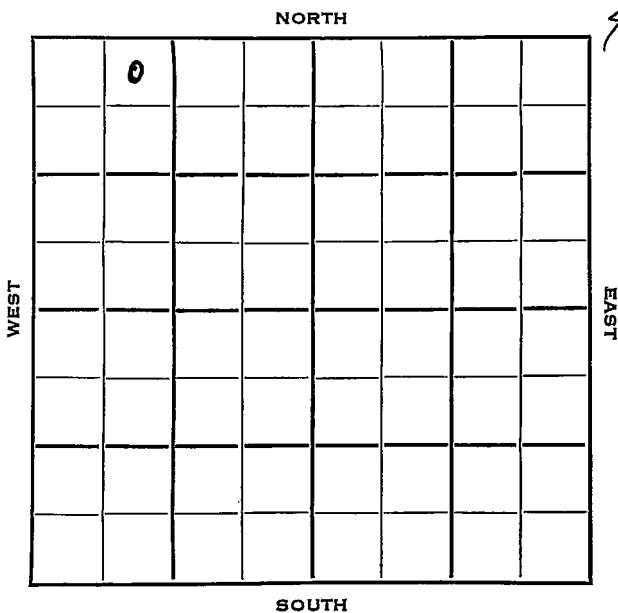

Marion KANSAS ✓

Sec. 2 Twp. 17 R. 4E

Well No. #1 Martin Farm

Irvin Daetwiler et al Company

Slusser Drlg. Contractor

Lost Springs Pool


330 Ft. from N. Line

Ft. from S. Line

Ft. from E. Line

990 Ft. from W. Line

NE NW NW

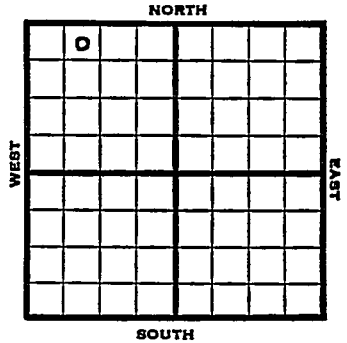

1953 Elev. 1425' REPORT

5/13

MIR

6/17

Spud 5-12-53

Oil Well

TD 2350'

8" @ 80'

Miss 2295,

4" @ 2298'

DD 2350 FU 1000' oil P/ 53 bopd

Comp. 30 bopd.

COMPLETED

County Marion State Kansas

Sec. 2 (Blk. 17 (Sur. Rge.) 4E Map No.

Operator Irvin Daetwiler et al.

Well No. 1 Farm Martin

Elev. _____ Location NE NW NW

0					

330 Ft. From N Line NE

990 Ft. From W Line Quarter

Ist. Report MAY 13 1953

Completion _____

Remarks _____

Slusser Drlg. - Contr.

Spudding Date _____

Drlg. Data Lost Springs Pool

M I R

County Marion State Kansas

Sec. 2 (Blk. 17 (Sur. 4E Map No.
(Twp.) (Rge.)

Operator Irvin Daetwiler etal.

Well No. 1 Farm Martin

Elev. 1425 Location NE NW NW

2						

330 Ft. From N Line NE
990 Ft. From W Line Quarter

1st. Report

Completion JUN 17 1953

Remarks Lost Springs Pool

Slusser Drlg. - Contr.

Spudding Date 5-12-53

Drlg. Data Oil well TD 2350

8" @ 80 Miss. 2295 4" @ 2298

DD 2350 FU 1000' oil P/ 53 bopd

Comp. 30 bopd