


DX 78-1 Marion

Section 2 Township 17 Range 4E

Well No. #2 Martin

Company Irwin Daetwiler et al.

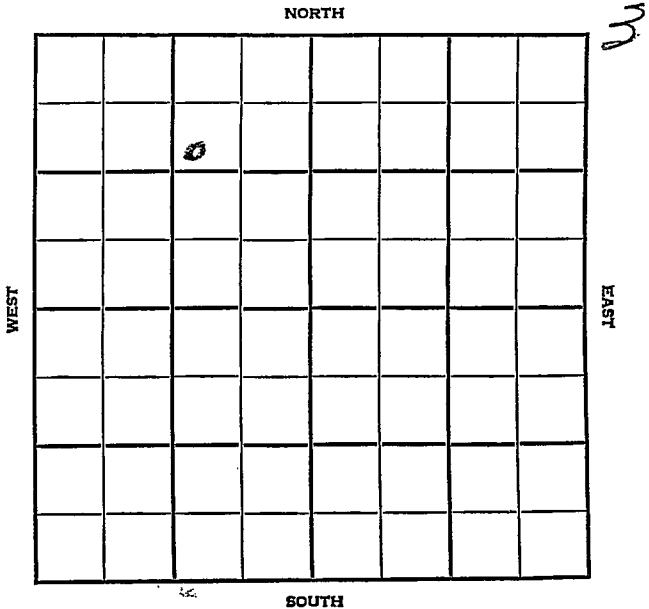

Marion

KANSAS

SEC. 2	TWP. 17	R. 4E
-----------	------------	----------

WELL NO. #2 Martin FARM

COMPANY Irwin Daetwiler et al.

CONTRACTOR Slusser

Lost Springs


_____ Ft. from N. Line

_____ Ft. from S. Line

_____ Ft. from E. Line

_____ Ft. from W. Line

SW NE NW

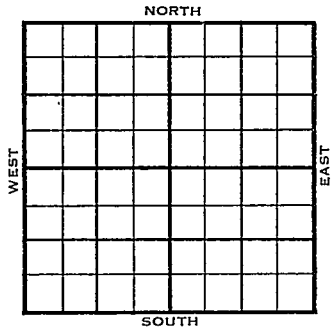

1955	ELEVATION	REPORT
------	-----------	--------

6/1

Comm. 5-9-55
 8" @80 5"@2292 DD 2304 sd-oil-frac.
 FU 175' oil 2 hr. Comp 25 bopd
 Miss Ch Depth 2287
 TD 2292

FIRST REPORT



COMPLETED

