

KANSAS


Marion

FORM 51 5M 10-41 PETROL

Section 20 Township 17 Range 1-E

Well No. #1 Decker

Company ~~Ring Mac~~ Ward McGinnis

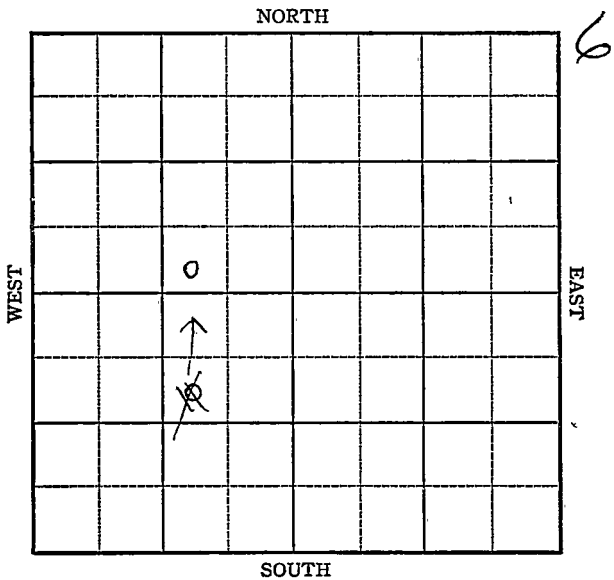

Sec. 20 Twp. 17 R. 1-E

Well No. #1 Decker Farm

~~Ring-Mae. Ward~~ McGinnis Company


Lost spring

_____ Ft. from N. Line

330 Ft. from S. Line

990 Ft. from E. Line

_____ Ft. from W. Line

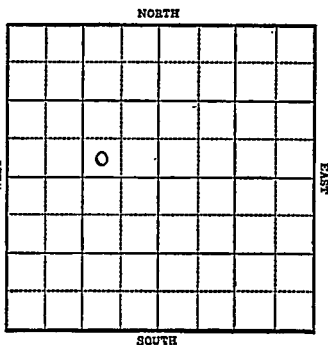

SW SE NW

R E P O R T

1943

- 2/3 Location.
- 2/10 8" @ 135'
Drlg. 175'
- 2/17 Drlg. 2580'
- 2/24 Lans 2204
Miss. 2813
T.D. 2852'
No shows.

ABANDONED

Marion

KANSAS Map No. 25 Sec. 20 Twp. 17 R. 1E

Well No. 1 Decker

Ring-Mac Company

FIRST REPORT Contractor

SW SE NW

SECTION PLAT

_____ Ft. from N. Line

330 Ft. from S. Line

990 Ft. from E. Line

_____ Ft. from W. Line

| | | | |
|--|---|--|--|
| | | | |
| | | | |
| | o | | |
| | | | |
| | | | |

LOST SPRING POOL

Location XXXXX

Rig up _____

Drilling and Remarks:

RECORD

Cased _____ in., _____ ft.

Sand _____

Gas _____

Oil _____

Total Depth _____

PRODUCTION

1st 24 hrs. Nat. _____

1st 24 hrs. after shot _____

Gas _____ Cu. Ft.

Dry Hole _____

Abandoned _____

Date

FEB 3 1943

S. J. LEWIS Scout

Marion

KANSAS

Map No. 25 Sec. 20 Twp. 17 R. 1E

Well No. 1 Decker

Ward McGinnis Company

ABANDONED Contractor

SW SE NW

SECTION PLAT

_____ Ft. from N. Line

330 Ft. from S. Line

990 Ft. from E. Line

_____ Ft. from W. Line

| | | | |
|--|--|--|--|
| | | | |
| | | | |
| | | | |
| | | | |

LOST SPRING POOL

Location _____

Rig up _____

Drilling and Remarks:

Lans 2204
Mis 2813
Noelhowe

RECORD

Cased _____ in., _____ ft.

Sand _____

Gas _____

Oil _____

Total Depth 2852

PRODUCTION

1st 24 hrs. Nat. _____

1st 24 hrs. after shot _____

Gas _____ Cu. Ft.

Dry Hole _____

Abandoned _____

Date

FEB 24 1943 19

S. J. LEWIS Scout