


Marion

KANSAS

SECTION 20 TOWNSHIP 17S RANGE 4E

WELL NO. #1 Scully

COMPANY Irving Daetwiler

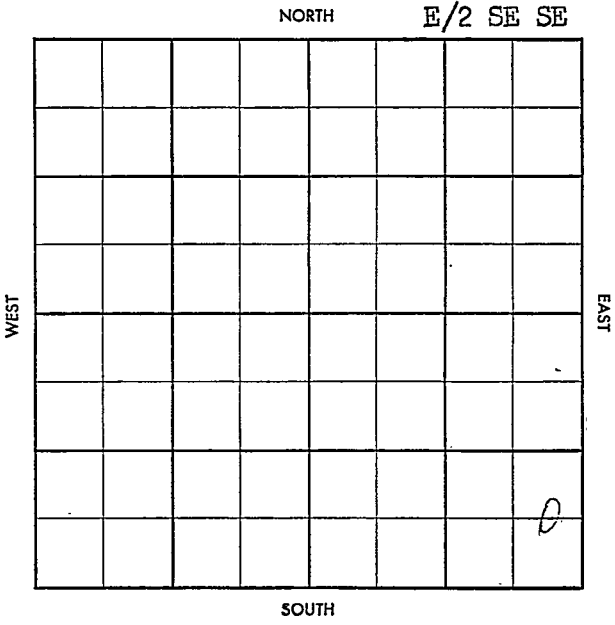

CO. Marion ELEV. _____
SEC. 20 TWP. 17 RGE. 4E
COMPANY Irving Daetwiler NO. 1

COMPLETE

OCT 16 57

OCT 16 57

FARM Scully

LOC. E/2 SE SE

KCLi 1790	
Mchat 2383	
KCS 178	
TD 2383	

GEOL. _____

CONTR. Augusta Tools

POOL Lost Springs

SPUD 9-30-57

8" @ 212 w/175, WOC

OCT 9 57 5 1/2 238 1/2

~~CO~~ OCT 9 2383

DD 2408

500A

25 BOPt NW

CO.

LSE.

NO.

SEC.

TWP.

RGE.