

Marion


KANSAS

Form 51-5M-7-39-Palace

Section 21 Township 17 Range 4-E

Well No. #3 Bevans

Company Phillips

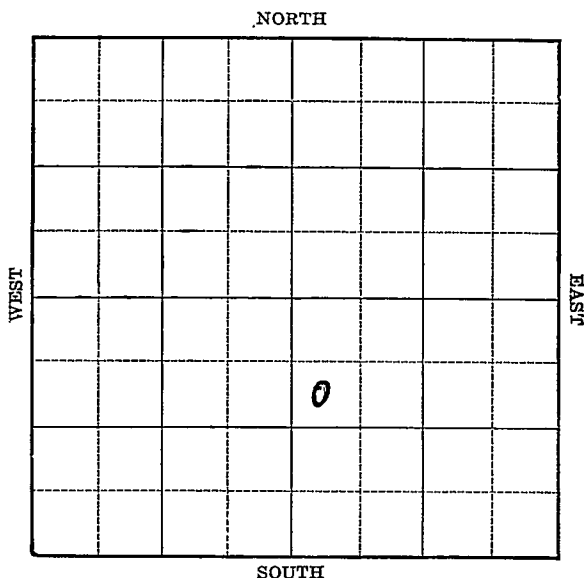

KANSAS


Marion

Sec. 21 Twp. 17 R. 4-EWell No. #3 Bevans FarmPhillips Company

(Novak)

990 Ft. from N. Line Ft. from S. Line Ft. from E. Line330 Ft. from W. Line

Elev. 1462

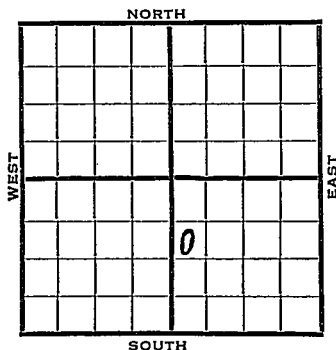

1940

REPORT

4/3

Location

4/12

Cellar.

4/18

R.U. Machine.

4/25

12" - 84' Drlg. 966'

5/2

10" - 1476' Drlg. 1625'

5/9

Drlg. 2085'

5/16

Miss. 2350-60' T.D. S.O.

5" - 2360'

5/23

T.D. 2399' 1200' oil 10½ hrs.

5/29

" " " " "

6/6

500 acid. Pump 116 oil & 25
water in 24 hours.

6/12

Chat. 2350'

5" - 2360'

T.D. 2399'

500 acid.

Pump 152 oil & 51 water.

COMPLETED

Marion

KANSAS

Map No. 26 Sec. 21 Twp. 17 R. 4EWell No. 3 BevansPhillips

Company

Contractor

FIRST REPORT

SW NW SE

SECTION PLAT

		o	

990 Ft. from N. Line Ft. from S. Line Ft. from E. Line330 Ft. from W. Line

NOVAK POOL

Location XRig up

Drilling and Remarks:

RECORD

Cased in., ft.Sand Gas Oil Total Depth

PRODUCTION

1st 24 hrs. Nat. 1st 24 hrs. after shot Gas Cu. Ft.Dry Hole Abandoned

A

Date

APR 3 1940

19

S. J. LEWIS Scout

Form 26—200 Bks.—1-40—Palace Marion **KANSAS**

Map No. 26 Sec. 21 Twp. 17 R. 4E

Well No. 3 Neva

Phillips Company

Contractor

COMPLETED

990 SW NW SE
Ft. from N. Line

 Ft. from S. Line

 Ft. from E. Line

330 Ft. from W. Line

NOVAK POOL

SECTION PLAT

Location

Rig up

Drilling and Remarks:

Chas 2350

5" @ 2360

500 acid

Pump 152 oil

51 Water

RECORD

Cased in., ft.

Sand

Gas

Oil

Total Depth 2399

PRODUCTION

1st 24 hrs. Nat.

1st 24 hrs. after shot

Gas Cu. Ft.

Dry Hole

Abandoned

Date

JUN 12 1940 19 S. J. LEWIS Scout