


Map No. **KANSAS** Sec. **21** Twp. **17** R. **4**
 Well No. **#1-H** **Shawnee** Farm
Prairie O. & G. Company

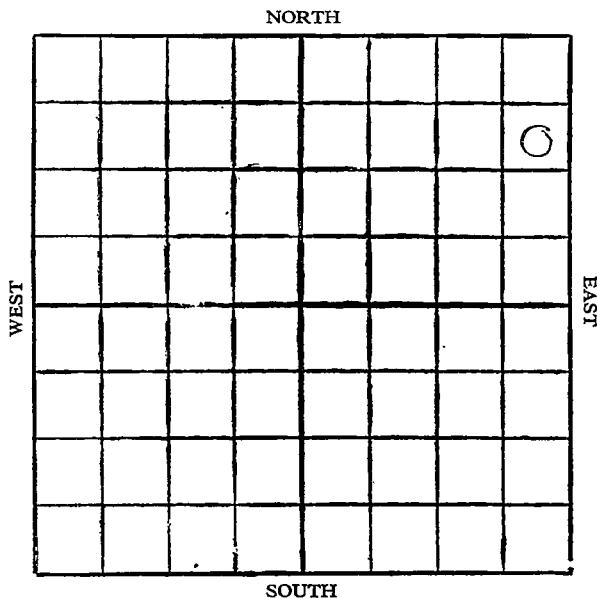

Location

Drilling Remarks

Rig Up

Drilling Remarks

RECORD

Cased in. ft.

Sand

Gas

Oil

Total Depth

PRODUCTION

1st 24 hrs. Nat.

1st 24 hrs. after shot

Gas cu. ft.

Dry Hole

Abandoned

KANSAS

Map No. 21 Sec. 17 Twp. 4 R. E# 1-77A Mowrer FarmPrairie O. G. Company


NORTH

990 Ft. from N. Line

Ft. from S. Line

330 Ft. from E. Line

Ft. from W. Line

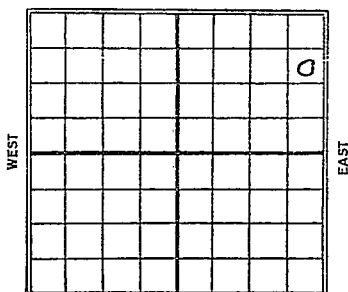

SOUTH

1928

Date	REPORT
2/9	Rigging up
2/15	Rigging up
2/23	Spudding 215-
3/1	Drlg 1375
3/8	" 1650
3/16	" 2280.
3/22	S.D. 2400
3/29	Chat 2387-2457-S.D. 2520.
4/5	7/13
4/12	7/19
4/19	7/26
4/26	8/2
5/3	8/8-Chat 2387
5/10	to 2457
5/15	D. + Q. 2520'
5/24	
5/31	
6/7	
6/14	
6/21	
6/28	
7/6	

no tracing
 KANSAS Marion
 Map No. _____ Sec. 21 Twp. 17 R. 4

Well No. 2 Mowbray
 Prairie Oil & Gas Co. Company

Contractor

FIRST REPORTS

990 Ft. from N. Line

_____ Ft. from S. Line

330 Ft. from E. Line

_____ Ft. from W. Line

SECTION PLAT

			o

Location _____

Rig up _____

Drilling and Remarks:

Rigging up

RECORD

Cased _____ in., _____ ft.

Sand _____

Gas _____

Oil _____

Total Depth _____

PRODUCTION

1st 24 hrs. Nat. _____

1st 24 hrs. after shot _____

Gas _____ Cu. Ft.

Dry Hole _____

Abandoned _____

Date

FEB 9 1928 CHAS. L. SHERWOOD

192

Scout

Mation

KANSAS
 Map No. 21 Sec. 21 Twp. 17 R. 4
 Well No. 1st Mowder
Prairie Oil & Gas Co Company

Contractor

CORRECTION

990 Ft. from N. Line

_____ Ft. from S. Line

330 Ft. from E. Line

_____ Ft. from W. Line

SECTION PLAT

			0

Location _____

Rig up ham up

Drilling and Remarks:

Previously reported
as #2. Chg
to #1st.

RECORD

Cased _____ in., _____ ft.

Sand _____

Gas _____

Oil _____

Total Depth _____

PRODUCTION

1st 24 hrs. Nat. _____

1st 24 hrs. after shot _____

Gas _____ Cu. Ft.

Dry Hole _____

Abandoned _____

Date

FEB 15 1928

192 CHAS. L. SHERWOOD

Scout

Map No. *no Iowa* **KANSAS** Sec. *21* Twp. *17* R. *4*
 Well No. *17* *Mower*
Travis Oil Co Company

Contractor

COMPLETED

990 Ft. from N. Line

Ft. from S. Line

330 Ft. from E. Line

Ft. from W. Line

ABANDONED

SECTION PLAT

			<i>0</i>

Location

Rig up

Drilling and Remarks:

*Chat 2387-2457'**Dtg 2520'*

RECORD

Cased _____ in., _____ ft.

Sand _____

Gas _____

Oil _____

Total Depth *2520'*

PRODUCTION

1st 24 hrs. Nat. _____

1st 24 hrs. after shot _____

Gas _____ Cu. Ft.

Dry Hole ☒Abandoned ☒

Date

AUG 8 1928

192

CHAS. L. SHERWOOD

Scout

MAP No. _____ SEC. 21 TWP. 175 R. 4EWELL No. 1 MaurerPrarie

COMPANY _____

CONTRACTOR _____

SECTION PLAT

_____ Ft. FROM N. LINE

_____ Ft. FROM S. LINE

_____ Ft. FROM E. LINE

_____ Ft. FROM W. LINE

LOCATION _____

RIG UP _____

DRILLING AND REMARKS:

RECORD

CASED _____ IN. _____ FT.

SAND _____

GAS _____

OIL _____

TOTAL DEPTH 2570

PRODUCTION

1ST 24 HRS. NAT. _____

1ST 24 HRS. AFTER SHOT _____

GAS _____ CU. FT.

DRY HOLE ☒ABANDONED ☒

DATE

8/9 192 8

SCOUT _____