


SECTION 21 TOWNSHIP 17 RANGE 4E

WELL NO. #2 Novak

COMPANY Augusta Oil

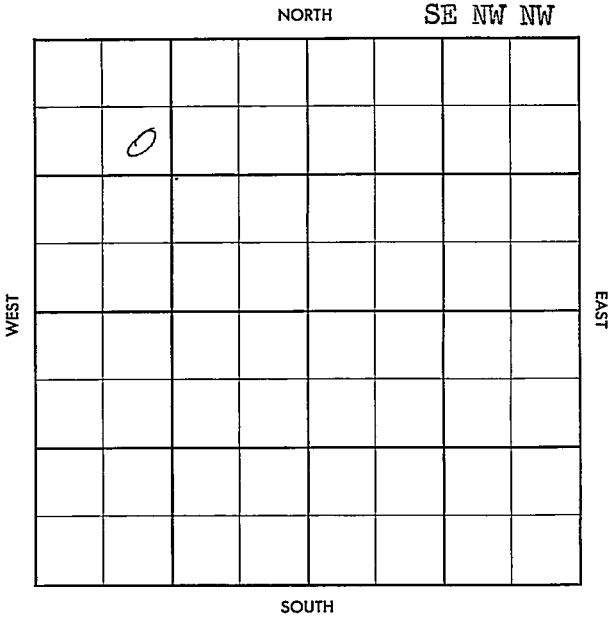

County Mason Elev. _____
 Sec. 21 Twp. 17 Rge. 1E
 Company Augusta Oil
 Farm Name Novak No. 2

TOPS	DEPTH	LOG	DATUM
Anh.			
Tp.			
H.			
Tr.			
Dg.			
BL.			
L.			
K.C.			
B.K.C.			
Ce.			
C.			
M.			
M.			
K.			
Mz.			
Me.			
V.			
S.			
S.			
A.			
R.			
PE.			
G.			
T.P.			

Loc. in Sec. _____
SE NW NW
990' NL
1100' WL
 Geol. _____
 Contr. _____
Co. tools
 Pool _____
Lost Springs

FIRST REPORT		
MAY 1 '57		

Date Comm. _____
Location

(Large handwritten scribble or signature)

Co.
Lse.
T. No.
Sec.
T.
R.

County Marion Elev. 1456
 Sec. 21 Twp. 17 Rge. 1E

TOPS	DEPTH	LOG	DATUM	Loc. in Sec.
Anh.				00 00 00
Ip.				
H.				0001 N
Tr.				
Dg.				11001 W
BL				
L.				Geol.
K.C.	1762			
B.K.C.				Contr
Ce.				No. tool
C.				
M. chat	2386			Pool
M.				Lost Springs
K.				
Mz.				
Mo				
V.				
S.				
S.				
A				
R.				
PE.				
G.				
T.D.	2389	2385		

JUL 24 '57
 COMPLETE

Date Comm.

Location MAY 8 '57 MIRT MAY 15 '57 ✓
MAY 22 '57 5-6-57 858 125/
9 1/2 ²³⁸⁸ ~~2384~~ MAY 23 '57 WACT JUN 5 '57
JUN 12 '57 DD 2409 1/2 F12C
Lost Ld. JUN 19 '57 TEK JUN 26 '57 JUL 3 '57
JUL 10 '57 ✓ JUL 17 '57 JUL 24 '57 P 5
Boyd + lots wth.