


DX 78-1 Marion

KANSAS

Section 22 Township 17 Range 4E

Well No. #1 Holscher

Company Scotty Zinn et al

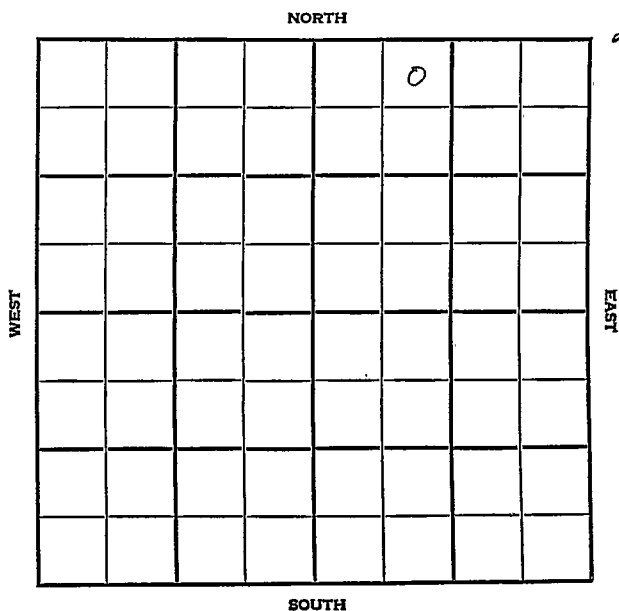

Marion

KANSAS

SEC.

TWP.

R.

22

17

4E

WELL NO.

#1 Holscher

FARM

COMPANY

Scotty Zinn etal

CONTRACTOR

Slusser

Lost Springs

FT. FROM N. LINE

FT. FROM S. LINE

FT. FROM E. LINE

FT. FROM W. LINE

NE NW NE

NORTH

					0		

WEST

EAST

SOUTH

1956

ELEVATION

1510'

REPORT

7-18

Comm. 7-16-56

8" @ 167 w/90

RUR

8-22

5½" @ 2404

DD 2427

Frac; S/ld.

P/ 15 BOPD / 15 BWPD

M. 2398';

TD 2404'

COMPLETED

Date Comm.	7-16-56	JUL 18 '56	Sec.
	8" @ 167/90 R U R		

2291 2 S JUL

50

County Marion Elev. 570
 Sec. 22 Twp. 17 Rge. 11
 Company Scotty Zinn et al.
 Farm Name Holscher No. 1

TOPS	DEPTH	LOG	DATUM	Loc. in Sec.
Anh.				
TP.				
H.				
Tr.				
Dg.				
Bl.				
L.				
K.C.				Geol.
B.K.C.				Contr.
Ce.				
C.				Blusser
M.	2398			
M.				Pool
K.				Port Summings
Mz.				
Mo.				
V.				
S.				
S.				
A.				
R.				
Pe.				COMPLETE
G.				
TD.	2404			

Date Comm. 7-1-56 AUG 22 1956

8th 167/10 R 11 JUL 3 56 5 1/2 @ 2404

AUG 1 56 MICT AUG 8 56 11D 2427 TP

550 Frac 8 Ld. AUG 15 56 POY

AUG 22 56 P. 15 Bapd + 15 Bwpd.