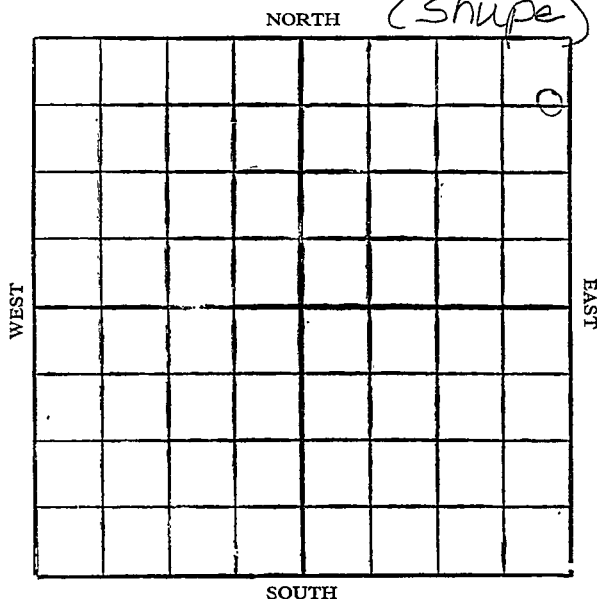


Map No. **KANSAS** Sec. **22** Twp. **17** R. **4**Well No. **1 - Shoop** Farm**Loriane & Robinson** Company

Location .....

Drilling Remarks

Rig Up .....

Drilling Remarks

## RECORD

Cased ..... in. .... ft.

Sand .....

Gas .....

Oil .....

Total Depth .....

## PRODUCTION

1st 24 hrs. Nat. ....

1st 24 hrs. after shot .....

Gas ..... cu. ft.

Dry Hole .....

Abandoned .....

Well No. 1-Shoop Farm

Loraine & Robinson Company


**NORTH**

662 Ft. from N. Line

Ft. from S. Line

60 Ft. from E. Line

Ft. from W. Line

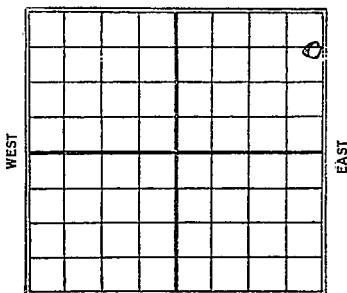

**SOUTH**

1928

Date \_\_\_\_\_

## REPORT

|      |                       |
|------|-----------------------|
| 2/1  | Rig                   |
| 1/9  | Spudding              |
| 2/16 | Drilg - 1180          |
| 4/23 | " 1965                |
| 3/1  | U.R. 2362             |
| 3/8  | Chat 2384 - 2417 -    |
|      | 1700' oil in hole -   |
| 3/15 | 2384 - 2417 T.D. 2417 |
|      | 65 bbls               |

KANSAS

Map No. \_\_\_\_\_ Sec. 22 Twp. 17 R. 4

Well No. 1 Shoop

Lorian &amp; Robinson Company

Contractor

## FIRST REPORTS

## SECTION PLAT

662 Ft. from N. Line

\_\_\_\_\_ Ft. from S. Line

60 Ft. from E. Line

\_\_\_\_\_ Ft. from W. Line

|  |  |  |   |
|--|--|--|---|
|  |  |  | 0 |
|  |  |  |   |
|  |  |  |   |
|  |  |  |   |

Location \_\_\_\_\_

Rig up ☒

Drilling and Remarks:

## RECORD

Cased \_\_\_\_\_ in., \_\_\_\_\_ ft.

Sand \_\_\_\_\_

Gas \_\_\_\_\_

Oil \_\_\_\_\_

Total Depth \_\_\_\_\_

## PRODUCTION

1st 24 hrs. Nat. \_\_\_\_\_

1st 24 hrs. after shot \_\_\_\_\_

Gas \_\_\_\_\_ Cu. Ft.

Dry Hole \_\_\_\_\_

Abandoned \_\_\_\_\_

Date

FEB 1 1928

CHAS. L. SHERWOOD

192

Scout

KANSAS

Map No. *No. 1* Sec. *22* Twp. *17* R. *4*Well No. *1* *Shoop*  
*Harvey & Robinson* Company

Contractor

## COMPLETED

## SECTION PLAT

*662* Ft. from N. Line

Ft. from S. Line

*60* Ft. from E. Line

Ft. from W. Line

|  |  |  |          |
|--|--|--|----------|
|  |  |  | <i>0</i> |
|  |  |  |          |
|  |  |  |          |
|  |  |  |          |

Location

Rig up

Drilling and Remarks:

*65* *ff*

## RECORD

Cased *7384-7417* in., ft.

Sand

Gas

Oil

Total Depth *7417*

## PRODUCTION

1st 24 hrs. Nat.

1st 24 hrs. after shot

Gas Cu. Ft.

Dry Hole

Abandoned

Date

MAR 15 1928

CHAS. L. SHERWOOD

Scout