


Map No. **KANSAS** Sec. 22 Twp. 17 R. 4
 Well No. 1 - Smith Farm
Braden & McClure Company

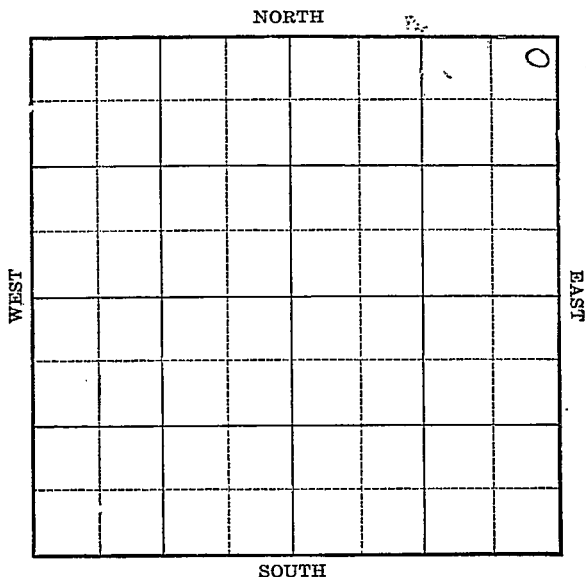

Location _____
 Drilling Remarks _____

Rig Up _____
 Drilling Remarks _____

RECORD


Cased _____ in. _____ ft.
 Sand _____
 Gas _____
 Oil _____
 Total Depth _____

PRODUCTION

1st 24 hrs. Nat. _____
 1st 24 hrs. after shot _____
 Gas _____ cu. ft.
 Dry Hole _____
 Abandoned _____

Map No. KANSAS Sec. 22 Twp. 17 R. 4
 Well No. 1-Smith Farm
Braden & McCure Company

NORTH

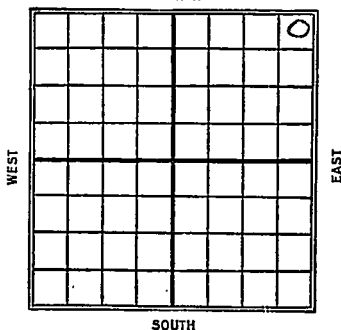

306 Ft. from N. Line

_____ Ft. from S. Line

222 Ft. from E. Line

_____ Ft. from W. Line

1928

Date

REPORT

1/11	R.P.G.
1/18	Rigging up-
4/16	Drilg 560-
2/2	" 1450
2/9	" 2110
4/16	Chat 2373-2433-
	Drawn 50 bbls 7-hrs-
2/23	Chat 2373-2433
	T.D. 2433 50 bbls

KANSAS

Map No. *22* Sec. *22* Twp. *17* R. *4*Well No. *1* *Smith*
Braden & Mc Clure Company

Contractor

FIRST REPORTS

SECTION PLAT

206 Ft. from N. Line

Ft. from S. Line

222 Ft. from E. Line

Ft. from W. Line

			0

Location *Box*Rig up *Box*

Drilling and Remarks:

RECORD

Cased _____ in., _____ ft.

Sand _____

Gas _____

Oil _____

Total Depth _____

PRODUCTION

1st 24 hrs. Nat. _____

1st 24 hrs. after shot _____

Gas _____ Cu. Ft.

Dry Hole _____

Abandoned _____

Date

JAN 11 1928

CHAS. L. SHERWOOD

102

Scout

Marion

Map No. KANSAS Sec. 22 Twp. 17 R. 4
 Well No. 1 Smith

Braden & McClure Company

Contractor

COMPLETED

SECTION PLAT

706 Ft. from N. Line

_____ Ft. from S. Line

222 Ft. from E. Line

_____ Ft. from W. Line

			Ø

Location _____

Rig up _____

Drilling and Remarks:

50 Ab.

RECORD

Cased _____ in., _____ ft.

2373-2433

Gas _____

Oil _____

Total Depth 2433

PRODUCTION

1st 24 hrs. Nat. _____

1st 24 hrs. after shot _____

Gas _____ Cu. Ft.

Dry Hole _____

Abandoned _____

Date

FEB 23 1928

192

CHAS. L. SHERWOOD

Scout