

Marion


KANSAS

DX 78-1

Section 22 Township 17 Range 4E

Well No. #1 Reznicek

Company Jess Cling et al

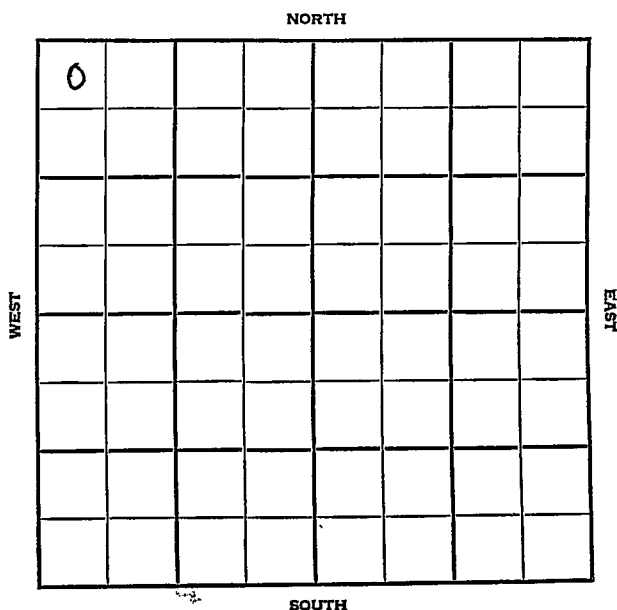

Marion KANSAS

SEC. 22	TWP. 17	R. 4E
------------	------------	----------

WELL NO.

1 Reznicek

FARM

COMPANY

Jess Cling et al

CONTRACTOR

Slusser Drlg.


Lost Springs Pool

330 Ft. from N. Line

Ft. from S. Line

Ft. from E. Line

330 Ft. from W. Line

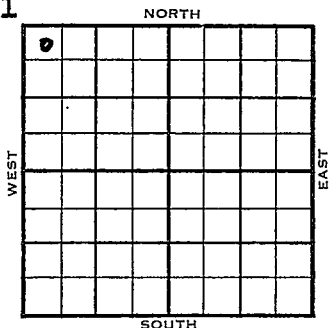

NW NW NW

1955

ELEVATION

REPORT

4/6
6/1

Location

Comm 5-4-55

Miss 2374, TD 2379

8 5/8" @ 96/75 5 1/2" @ 2375

DD 2412, FU 200' oil 2 hr 50% wtr

Comp 15 bopd 15 bw

COMPLETED

County Marion State KansasSec. 22 (Blk.) 17 (Sur.) 4E Map No.Operator Jess Cling et al.Well No. 1 Farm ReznicekElev. Location NW NW NW

0							

FIRST REPORT

330 Ft. From N Line NW330 Ft. From W Line Quarter1st. Report APR 6 1955

Completion

Remarks

Slusser Drlg. - Contr.

Spudding Date

Drlg. Data Lost Springs PoolLocation

FABEN GILSTRAP

County Marion Elev. _____
Sec. 22 Twp. 17 Rgs. 4E
Company Jess Cling etal.
Farm Name Reynicek No. 1

TOPS	DEPTH	LOG	DATUM	Loc. in Sec.
Anh.				NW NW NW
Tr.				
Dg.				
Bl.				
L.				
K.C.				Geol. _____
B.K.C.				Contr. _____
Ce.				Slusser
C.				Pool
M. <u>iss</u>	<u>2374</u>			Lost Springs
M.				
K.				
Mz.				
Ma.				
V.				
S.				
S.				
A.				
R.				
Pe.				
G.				
ED.	<u>2379</u>			

Date Comm. 5-4-55 JUN 1 1955
.8 5/8" @ 96/ 75 .5 1/2" @ 2375
DD 2412 FU 200' oil 2 hr. 50% wtr.
Comp. 15 bopd 15 bw