

Marion

Map No. Kansas Sec. 22 Twp. 17 R. 4^E


Well No. 1 - Ragnok Farm
Phillips Pet Company

330 Ft. from N. Line

_____ Ft. from S. Line

_____ Ft. from E. Line

330 Ft. from W. Line

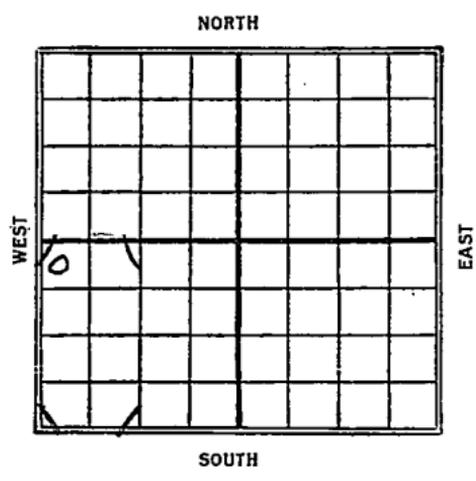

Date 1926	REPORT
1/12	Location
1/19	Timbers
1/26	Bldg rig
2/3	Rig
2/10	Rigging up
2/17	Drlg 450
2/24	" 1045
3/2	" 1625
3/9	" 2100
3/16	fishing 2100
3/24	Drlg 2325
3/30	Top chat 2392 - 1st oil 2398 - T.D. 2418 - 2400' oil in hole - Bldg. tankage
4/7	_____
4/16	Chat 2387-2410 - Drlg to 2441 - T.D. in chat - Pumped 240 bbls. oil - 10 bbl. water - 38. gravity oil -
4/20	S.D. engine trouble
4/27	T.D. 2418 - swabbed 455 bbls. bbls. in 12 hrs. shutdown -
5/5	_____


5/11 - Sand 2383-2410
P.B. to 2409 639 bbls

Marion E

Map No. *KANSAS* Sec *22* Twp. *17* R. *4*

Well No. *1* *Baker* Farm
Phillips pet Co Company

NORTH

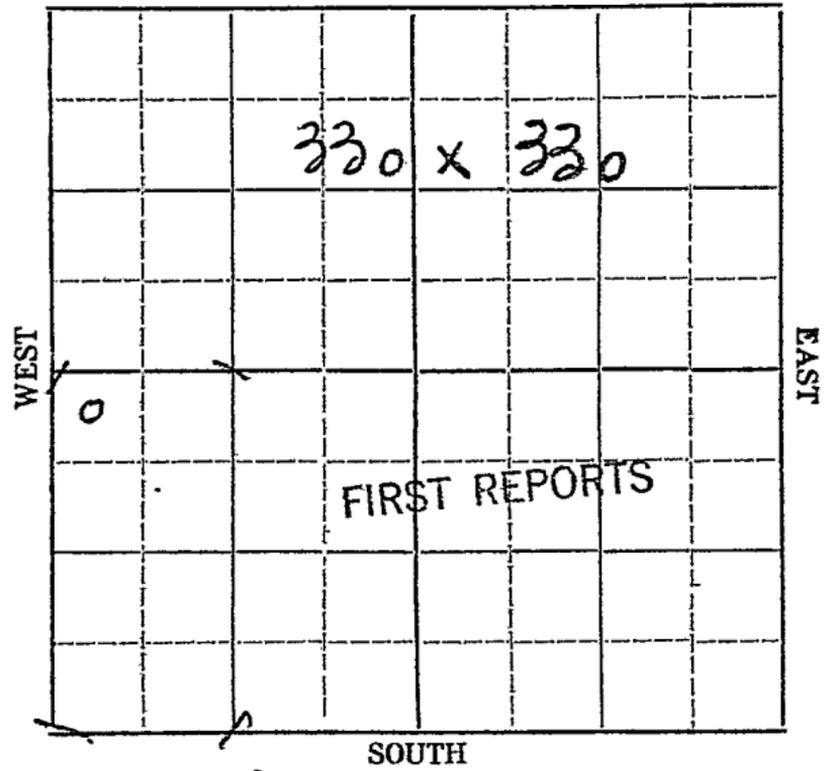

Location

Rig up _____

Drilling and Remarks:

RECORD

Cased _____ in., _____ ft.
 Sand _____
 Gas _____
 Oil _____
 Total Depth _____

PRODUCTION

1st 24 hrs. Nat. _____
 1st 24 hrs. after shot _____
 Gas _____ Cu. Ft.
 Dry Hole _____
 Abandoned _____

Date **JAN 1 2 1927** # **CHAS. L. SHERWOOD**
 192 _____ Scout

Returned	
Card	<i>[Handwritten mark]</i>
Tracing	<i>none</i>
France Map	

*NO WALL MAP
NO SMALL MAP*

Thalions

6/1

KANSAS

Map No. _____ Sec. *22* Twp. *17* R. *4*

Well No. *1* *Bazner*

Phillips Pet Co Company

Contractor

COMPLETED

SECTION PLAT

230 Ft. from N. Line

_____ Ft. from S. Line

_____ Ft. from E. Line

230 Ft. from W. Line

Collection

Location _____

RECORD

Rig up _____

Cased _____ in. _____ ft.

Sand *2383-2410*

Gas _____

Oil _____

Total Depth *2410*

Drilling and Remarks:

Plugged back to

2409'

639 Bbls

PRODUCTION

1st 24 hrs. Nat. _____

1st 24 hrs. after shot _____

Gas _____ Cu. Ft.

Dry Hole _____

Abandoned _____

Date
MAY 1 1927

CHAS. L. SHERWOOD

_____ 192 _____ Scout

NO WALL MAP
NO SMALL MAP

Returned	
Cards	<i>none</i>
Tracing	<i>None</i>
France Map	
Scarborough Map	
Moody Map	
Scarborough Plat Book	
Moody Plat Book	