


Map No. KANSAS Sec. 22 Twp. 17 R. 4

Well No. Geo Peterson Farm  
Phillips Pet Company

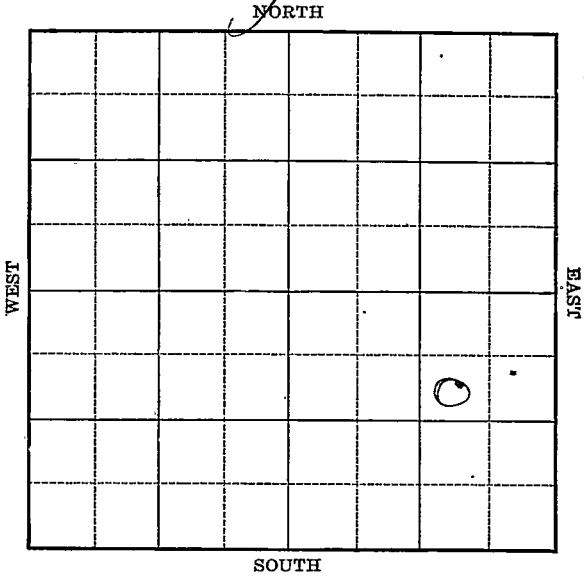

Location \_\_\_\_\_

Drilling Remarks \_\_\_\_\_

\_\_\_\_\_

\_\_\_\_\_

**RECORD**

Cased \_\_\_\_\_ in. \_\_\_\_\_ ft.

Sand \_\_\_\_\_

Gas \_\_\_\_\_

Oil \_\_\_\_\_

Total Depth \_\_\_\_\_

Rig Up \_\_\_\_\_

Drilling Remarks \_\_\_\_\_

\_\_\_\_\_

\_\_\_\_\_

**PRODUCTION**

1st 24 hrs. Nat. \_\_\_\_\_

1st 24 hrs. after shot \_\_\_\_\_

Gas \_\_\_\_\_ cu. ft.

Dry Hole \_\_\_\_\_

Abandoned \_\_\_\_\_

KANSAS

Map No. \_\_\_\_\_ Sec. 22 Twp. 17 R. 4

Well No. 1 - Geo Peterson Farm

Phillips Pet Company


990 Ft. from N. Line

\_\_\_\_\_ Ft. from S. Line

990 Ft. from E. Line

\_\_\_\_\_ Ft. from W. Line

1928

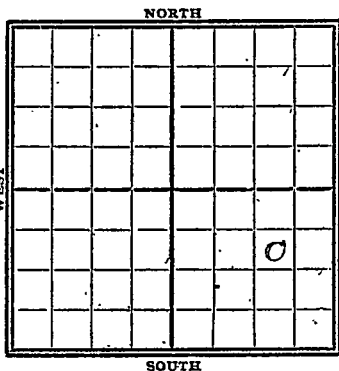

Date

REPORT

Date	REPORT
7/19	R.O.G.
7/26	Rig
8/2	Spudding 150'
8/9	" " 325'
8/7	Drlg. 1030
8/23	" 1550
8/28	" 1940
9/4	" 2125
9/12	Chat 2369-2409 swabbed 135 bbls 16 hrs.
9/19	sand 2369-2419 T.D. 150 bbls.
	<u>Coverup</u>

Marion

no map  
KANSAS  
MAP No. \_\_\_\_\_ SEC. 22 TWP. 17 R. 4

WELL No. 1 Geo Peterson  
Phillips pet Co COMPANY

CONTRACTOR

## SECTION PLAT

## FIRST REPORTS

990

FT. FROM N. LINE

FT. FROM S. LINE

990

FT. FROM E. LINE

FT. FROM W. LINE

			0

LOCATION \_\_\_\_\_

RIG UP \_\_\_\_\_

DRILLING AND REMARKS:

Rob

## RECORD

CASED \_\_\_\_\_ IN. \_\_\_\_\_ FT.

SAND \_\_\_\_\_

GAS \_\_\_\_\_

OIL \_\_\_\_\_

TOTAL DEPTH \_\_\_\_\_

## PRODUCTION

1ST 24 HRS. NAT. \_\_\_\_\_

1ST 24 HRS. AFTER SHOT \_\_\_\_\_

GAS \_\_\_\_\_ CU. FT.

DRY HOLE \_\_\_\_\_

ABANDONED \_\_\_\_\_

DATE

JUL 19 1928

CHAS. L. SHERWOOD

192

SCOUT

*Marion*

MAP NO. KANSAS SEC. 22 TWP. 17 R. 4  
*North*

WELL NO. 1 *Geo Peterson*  
Phillips Pet Co COMPANY

CONTRACTOR

**COMPLETED**

**SECTION PLAT**

990 FT. FROM N. LINE  
\_\_\_\_ FT. FROM S. LINE  
990 FT. FROM E. LINE  
\_\_\_\_ FT. FROM W. LINE

			0

LOCATION \_\_\_\_\_

RIG UP \_\_\_\_\_

DRILLING AND REMARKS:

*150 Rfs.*

**RECORD**

CASED \_\_\_\_\_ IN. \_\_\_\_\_ FT.

SAND 2369-2419

GAS \_\_\_\_\_

OIL \_\_\_\_\_

TOTAL DEPTH 2419

**PRODUCTION**

1ST 24 HRS. NAT. \_\_\_\_\_

1ST 24 HRS. AFTER SHOT \_\_\_\_\_

GAS \_\_\_\_\_ CU. FT.

DRY HOLE \_\_\_\_\_

ABANDONED \_\_\_\_\_

DATE

SEP 19 1928

CHAS. L. SHERWOOD

192

SCOUT