

Marion

KANSAS

SECTION 23 TOWNSHIP 17 RANGE 4 E

WELL NO. #5 Dunlap

COMPANY A I F A

NORTH

						0	

16

WEST

EAST

SOUTH

Marion

KANSAS

SEC.	TWP.	R.
23	17	4E

WELL NO.

#5 Dunlap

FARM

COMPANY

A M F A

CONTRACTOR

Slusser

Lost Springs


_____ Ft. from N. Line

_____ Ft. from S. Line

_____ Ft. from E. Line

_____ Ft. from W. Line

SW SE SE

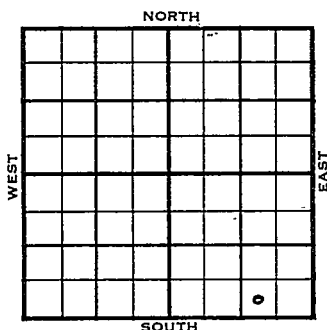

1955

ELEVATION

1450'

REPORT

11/16

Loc

1956

1-11

Comm. 11-18-55
 8 5/8" @ 204/100
 4 1/2" @ 2320/30
 DD 2345
 DD 2353
 Frac
 Comp. 9 bopd
 M. 2315'
 TD 2353'

COMPLETED

County Marion Elev. _____
 Sec. 23 Twp. 17 Rge. 4E
 Company A M F A
 Farm Name Dunlap No. 5

TOPS	DEPTH	LOG	DATUM
Anh.			
TP.			
H.			
Tr.			
Dg.			
BL.			
L.			
K.C.			
B.K.C.			
Ce.			
C.			
M.			
M.			
K.			
Mz.			
Me.			
V.			
S.			
S.			
A.			
R.			
PE.			
G.			
T.D.			

Loc. in Sec. SW SE SE

Geol. _____

Contr. _____

Slusser

Pool _____

Lost Springs

FIRST REPORT

Date Comm. _____

Location

NOV 16 1955

Co.

Lse.

No.

Sec.

T.

R.

County Marion Elev. 1450 Co.
 Sec. 23 Twp. 17 Rge. 4E
 Company A M F A
 Farm Name Dunlap No. 5

TOPS	DEPTH	LOG	DATUM	Loc. in Sec.
Anh.				SW SE SE
Tr.				
H.				
Tr.				
Dg.				
Bl.				
L.				Geol.
K.C.				Contr.
B.K.C.				Slusser
Ce.				Pool
C.				Lost Springs
M.	2315		865	
M.				
K.				
Mz.				
Mq.				
V.				
S.				
S.				
A.				
R.				
PE.				
G.				
T.D.	2321			

COMPLETE

Date Comm. 11-18-55 JAN 11 1956
8 5/8" @ 204/110 4 1/2" @ 2320/30 DD 2345
 DD 2353 frac Comp. 9 bopd