


Map No. **KANSAS** Sec. **23** Twp. **17** R. **4**
 Well No. **1- Folks** Farm
Braden & McClure Company

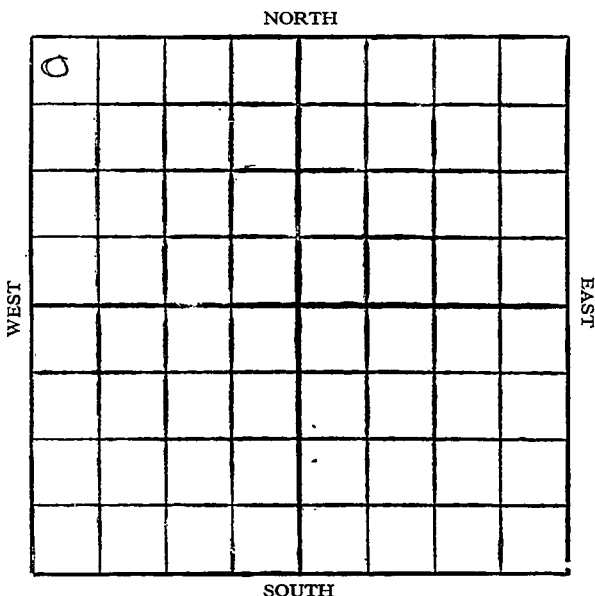

Location

Drilling Remarks

Rig Up.....

Drilling Remarks

RECORD

Cased..... in. ft.

Sand

Gas

Oil

Total Depth.....

PRODUCTION

1st 24 hrs. Nat.....

1st 24 hrs. after shot.....

Gas..... cu. ft.

Dry Hole.....

Abandoned.....


Map No. **KANSAS** Sec. **23** Twp. **17** R. **4**
 Well No. **1 - Folks** Farm
Braden & McChure Company

NORTH

206 Ft. from N. Line

_____ Ft. from S. Line

_____ Ft. from E. Line

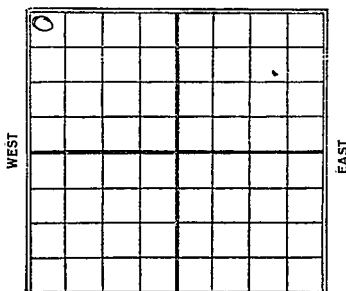200 Ft. from W. Line

SOUTH

1928

Date

REPORT

Date	REPORT
2/23	Rig up
3/11	Rig
3/8	Drilg - 350
3/16	" 1450
3/22	" 1820
3/29	Chat 2373-95 show oil - drilling -
4/5	Drilg 2458 - 8 bbl oil in 24 hrs -
4/12	Chat 2373 - 2445 8 bbl show N. & A. 2462'

Form 26—1M Bks.—3-23—11959. *Marion*
 Map No. *KANSAS* Sec. *23* Twp. *17* R. *4* ^E
 Well No. *1* *Polio*
Braden & Mc Elroy Company

Contractor

FIRST REPORTS

SECTION PLAT

206 Ft. from N. Line

_____ Ft. from S. Line

_____ Ft. from E. Line

200 Ft. from W. Line

0			

Location _____

Rig up _____

Drilling and Remarks:

RECORD

Cased _____ in., _____ ft.

Sand _____

Gas _____

Oil _____

Total Depth _____

PRODUCTION

1st 24 hrs. Nat. _____

1st 24 hrs. after shot _____

Gas _____ Cu. Ft.

Dry Hole _____

Abandoned _____

Date

FEB 23 1928

192

CHAS. L. SHERWOOD

Scout

KANSAS

Map No. *23* Sec. *23* Twp. *17* R. *4*Well No. *1* *Folks**Bradley & McClure* Company

Contractor

COMPLETED

SECTION PLAT





ABANDONED

0			

Location

Rig up

Drilling and Remarks:


RECORD

Cased _____ in., _____ ft.

Sand _____

Gas _____

Oil _____


PRODUCTION

1st 24 hrs. Nat. _____

1st 24 hrs. after shot _____

Gas _____ Cu. Ft.

Dry Hole ☒Abandoned ☒

Date

APR 12 1928

192 *CHAS. L. SHERWOOD*

Scout

MAP NO. _____ SEC. 73 TWP. 17S R. 4EWELL NO. 1 Rock_____Borden COMPANY_____no well map CONTRACTOR

SECTION PLAT

0			

_____ FT. FROM N. LINE_____ FT. FROM S. LINE_____ FT. FROM E. LINE_____ FT. FROM W. LINE

LOCATION _____

RIG UP _____

DRILLING AND REMARKS:

RECORD

CASED _____ IN. _____ FT.

SAND _____

GAS _____

OIL _____

TOTAL DEPTH 540

PRODUCTION

1ST 24 HRS. NAT. _____

1ST 24 HRS. AFTER SHOT _____

GAS _____ Cu. Ft.

DRY HOLE

ABANDONED _____

DATE

4/10 8

192

SCOUT