


Section 23 Township 17 Range 4E

Well No. 3 Sklenar

Company A. Louriaux

Lost Spring
NORTH

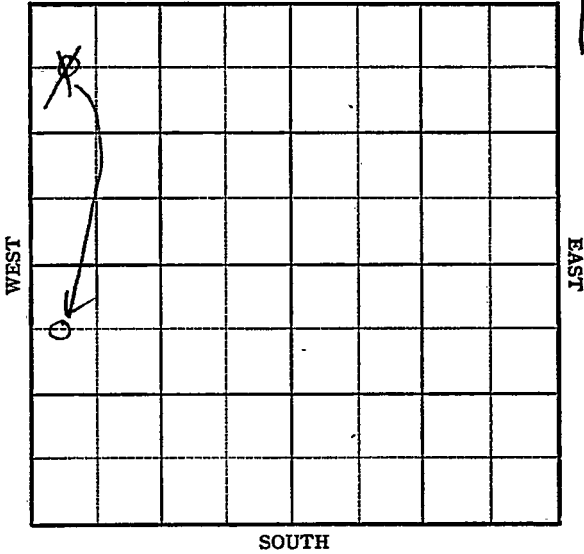

KANSAS

Marion



Sec. 23 Twp. 17 R. 4E

Well No. #3 Sklener Farm

A. Louriaux Company


Lost Spring

660' Ft. from N. Line

_____ Ft. from S. Line

_____ Ft. from E. Line

330' Ft. from W. Line

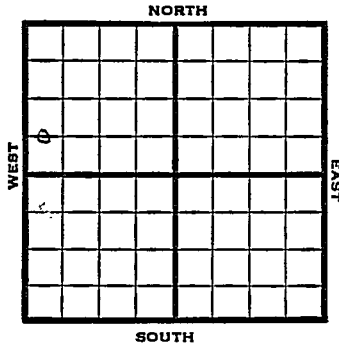

C W L NW SW

1949

Elev 1480' REPORT

3/2

8" @ 225'
Miss 2370'
TD 2371'
5" @ 2371'

3/8

"

3/16

"

3/23

TD 2422'
Miss 2370'
5" @ 2371'
Pump 40 Oil Pot
38° Gr.
Comp

COMPLETED

Kansas

Map No. _____ Sec. 23 Twp. 17 R. 4EWell No. 3 SklenarA. Louriaux Company**FIRST REPORT** Contractor

C W L NW SW

SECTION PLAT660 Ft. from N. Line

_____ Ft. from S. Line

_____ Ft. from E. Line

330 Ft. from W. Line

o			

Marion County

Location _____

Rig up _____

Drilling and Remarks: _____

8" @ 225

Miss. 2370-71 TD

5" @ 2371

RECORD

Cased _____ in., _____ ft.

Sand _____

Gas _____

Oil _____

Total Depth _____

PRODUCTION

1st 24 hrs. Nat. _____

1st 24 hrs. after shot _____

Gas _____ Cu. Ft.

Dry Hole _____

Abandoned _____

Date

MAR 2 1949 19S. J. LEWIS Scout

Kansas

Map No. 26 Sec. 23 Twp. 17 R. 4E

Well No. 3 Sklenar

A. Louriaux Company

COMPLETE. Contractor

C W L NW SW

E 11488
SECTION PLAT

660 Ft. from N. Line

*Correction
C.O. Survey
Barril*

Ft. from S. Line

Ft. from E. Line

330 Ft. from W. Line

9			
0			

Marion County

RECORD

Location _____

Cased _____ in., _____ ft.

Rig up _____

Sand _____

Drilling and Remarks:

Gas _____

Oil _____

Total Depth 2422

Miss 2370

5-102871

PRODUCTION

1st 24 hrs. Nat. _____

1st 24 hrs. after shot _____

Gas _____ Cu. Ft.

Dry Hole _____

Abandoned _____

Date

MAR 23 1949 19

S. J. LEWIS Scout