

KANSAS

Morris

Section 23 Township 17 Range 7-E

Well No. #1 Meyers

Company Westgate-Greenland
Miscellaneous

NORTH

	0						

WEST

EAST

SOUTH

Sec. 23 Twp. 17 R. 7E ✓

Well No. I Meyers Farm

Westgate-Greenland Company

Misc.


Contract Jackson

_____ Ft. from N. Line

330 Ft. from S. Line

_____ Ft. from E. Line

990 Ft. from W. Line

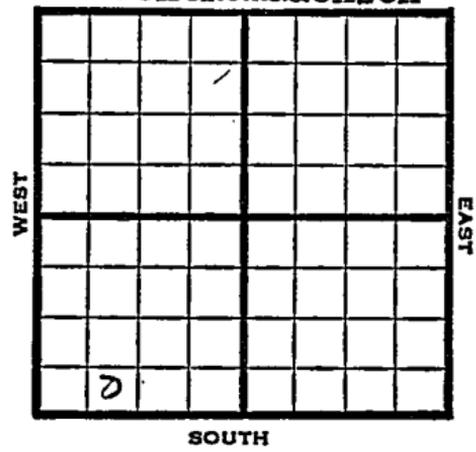

SE SW SW

1949

Elev 1523' REPORT

8/24

Location

8/31

TD 2244'
Lans 1448'
Arb. 2054'
Quartzite 2155'
Aband.

ABANDONED

Kansas

Map No. _____ Sec. 23 Twp. 17 R. 7EWell No. 1 Meyers

_____ Westgate - Greenland _____ Company

_____ Jackson _____ Contractor

SE SW SW

FIRST REPORT
SECTION PLAT

_____ Ft. from N. Line

330 Ft. from S. Line

_____ Ft. from E. Line

990 Ft. from W. Line

Morris County

Location X

Rig up _____

Drilling and Remarks: _____

RECORD

Cased _____ in., _____ ft.

Sand _____

Gas _____

Oil _____

Total Depth _____

PRODUCTION

1st 24 hrs. Nat. _____

1st 24 hrs. after shot _____

Gas _____ Cu. Ft.

Dry Hole _____

Abandoned _____

Date

AUG 24 1949 19S. J. LEWIS Scout

Kansas

Map No. K27 Sec. 23 Twp. 17 R. 7EWell No. I Meyers

Westgate-Greenland

Company

ABANDONED

Contractor

SE SW SW

E. 1523
SECTION FLAT

_____ Ft. from N. Line

330 Ft. from S. Line

_____ Ft. from E. Line

990 Ft. from W. Line

o			

Morris County

RECORD

Location _____

Cased _____ in., _____ ft.

Rig up _____

Sand _____

Drilling and Remarks:

Gas _____

Oil _____

Lease 1448Cr 2054Quartzite 2155Total Depth 2244

PRODUCTION

1st 24 hrs. Nat. _____

1st 24 hrs. after shot _____

Gas _____ Cu. Ft.

Dry Hole _____

Abandoned _____

Date

AUG 31 1949

19

S. J. LEWIS

Scout