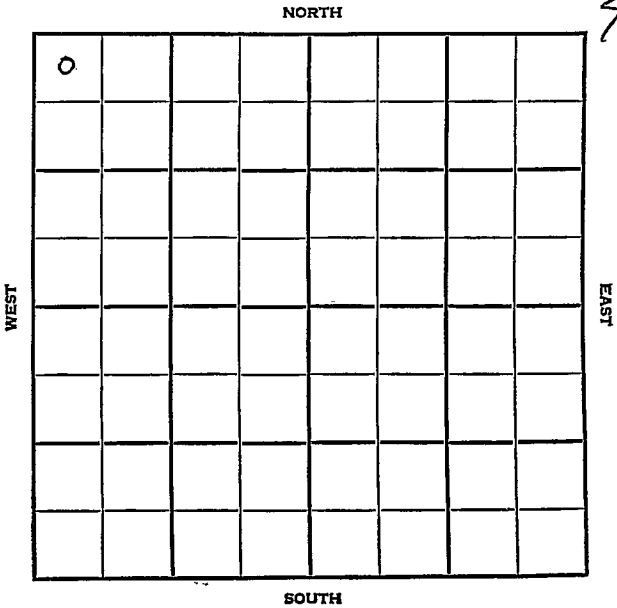


Section 24 Township 17 Range 4 EWell No. #1 ReznicekCompany Irwin Deatwiler

KANSAS

WELL NO.

#1 Reznicek

FARM

COMPANY

Irwin Daetwiler

CONTRACTOR

Augusta

Lost Springs

NORTH


Ft. from N. Line

Ft. from S. Line

Ft. from E. Line

Ft. from W. Line

NW NW NW

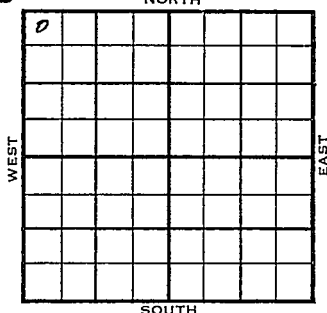

1955

ELEVATION

1455'

REPORT

9-14

Comm. 9-11-55

8th @ 203/125

Drlg. 418'

10/19

Comm 9-11-55

8th @ 203/125

5 1/2" @ 2322/25

M 2318

TD 2322

DD 2377

PB 2332 500A frac S/45 bfph

50% wtr Comp 25 bopd 25 bw

COMPLETED

County Marion

Elev. _____

Sec. 21Twp. 17Rge. 4ECompany Irwin DaetwilerFarm Name ReznickNo. 1

TOPS

DEPTH

LOG

DATUM

Loc. in Sec. _____

Anh. _____

Tp. _____

H. _____

Tr. _____

Dg. _____

Bl. _____

L. _____

K.C. _____

B.K.C. _____

Ce. _____

C. _____

M. _____

M. _____

K. _____

Mz. _____

Mq. _____

V. _____

S. _____

S. _____

A. _____

R. _____

Pe. _____

G. _____

T.D. _____

NW NW NW

Geol. _____

Contr. _____

Augusta

Pool _____

Lost Springs

D

FIRST REPORT

SEPT 4 55

Date Comm. 9-11-55

Bu @ 203/125 drlg. 418

County Marion Elev. 1455
 Sec. 24 Twp. 17 Rge. 4E
 Company Irwin Daetwiler
 Farm Name Reznicek No. 1

TOPS	DEPTH	LOG	DATUM	Loc. in Sec.
Anh.				NW NW NW
Tp.				
H.				
Tr.				
Dg.				
Bl.				
L.				
K.C.				Geol.
B.K.C.				Contr.
Ce.				Augusta
C.				Pool
M.	2318		863	Lost Springs
M.				
K.				
Mz.				
Mo.				
V.				
S.				
S.				
A.				
R.				
Pe.				
G.				
TD.	2322			

0			

COMPLETE

Date Comm. 9-11-55 OCT 1 '9 1955
8" @ 203/125 5 1/2" @ 2322/25 DD 2377
PB 2332 500 A frac S/45 b fph
50% wtr. Comp. 25 bopd 250w