


DX 78-1 Marion

KANSAS

Section 24 Township 17S Range 4E

Well No. #1 Reznicek

Company J. D. White & B. King

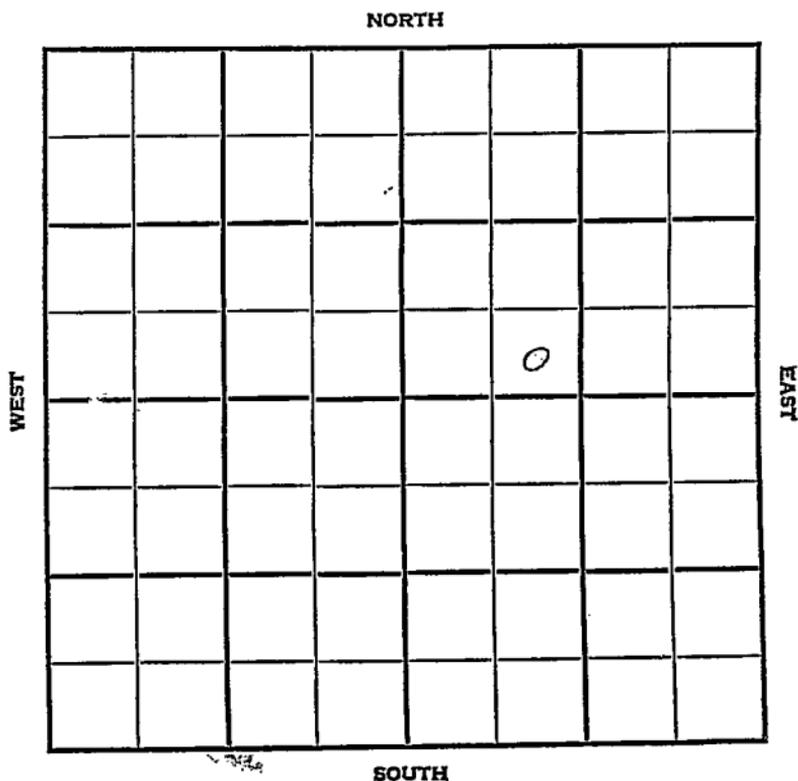

Marion

KANSAS

SEC. 24 - -

TWP. 17S


R. 4E

WELL NO. #1 Reznicek FARM

COMPANY J.D. White & B. King

CONTRACTOR Sunflower Lost Springs

\_\_\_\_\_ FT. FROM N. LINE  
\_\_\_\_\_ FT. FROM S. LINE  
\_\_\_\_\_ FT. FROM E. LINE  
\_\_\_\_\_ FT. FROM W. LINE

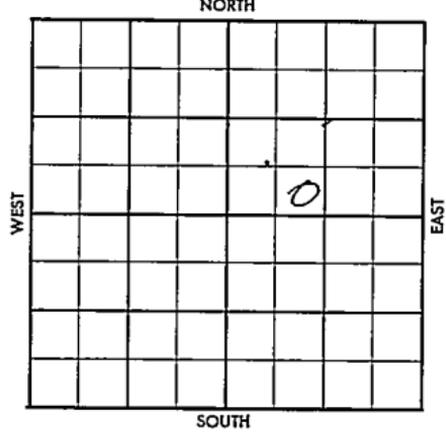

SE SW NE

1956

ELEVATION REPORT

7-25  
8-1 #

Location  
Abandoned Location

**ABANDONED**



Co.

Loc.

No.

Sec.

T.

R.

County Marion Elev. \_\_\_\_\_  
 Sec. 24 Twp. 17S Rge. 4E  
 Company J. D. White & B. King  
 Farm Name Reznicek No. 1

TOPSOIL	DEPTH	LOG	DATUM	Loc. in Sec.
Anh.				SE SW NE
Tp.				
H.				
Tr.				
Dg.				
Bl.				
L.				Geol.
K.C.				Contr.
B.K.C.				Sunflower
Ce.				Pool
C.				Lost Springs
M.				<div style="border: 1px solid black; padding: 5px; text-align: center;"> <p><b>ABANDONED</b></p> </div>
M.				
K.				
Mz.				
Mo.				
V.				
S.				
S.				
A.				
R.				
PE				
G.				
TR				

Date Comm. LOG. AUG 1 '56 AUG 1 1956

Abd. Loc.