


Section 26 Township 17 Range 4E

Well No. 1 Pritz

Company Loriaux et al

Lost Spring Pool

NORTH

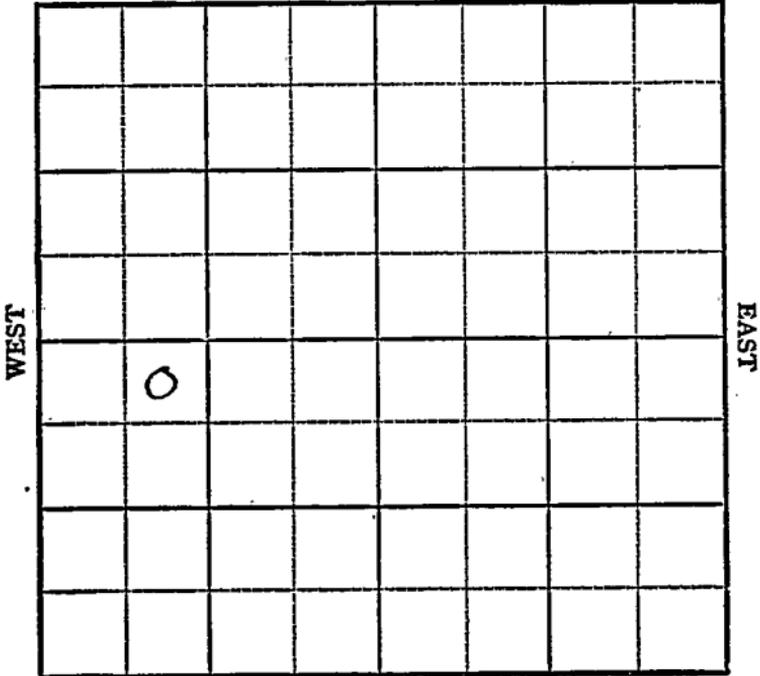

SOUTH

Sec. 26 Twp. 17 R. 4-E ✓

Well No. #1 Pritz Farm

Loriaux etal Company

Lost Sping


330 Ft. from N. Line

\_\_\_\_\_ Ft. from S. Line

\_\_\_\_\_ Ft. from E. Line

990 Ft. from W. Line

NE NW SW

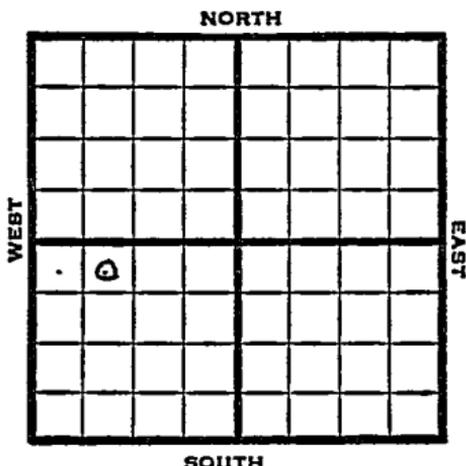

1948

REPORT

9/29

Location

10/6

8" @ 245'

Drlg 1890'

10/13

Mississippi 2321-27'

TD 2327'

5" @ 2326'

10/19

"

10/27

TD 2374'

Miss 2321'

5" @ 2326'

Pump & oil Pot

38° Gr.

Comp

**COMPLETED**

E

r

s

e

Map No. \_\_\_\_\_ Sec. 26 Twp. 17 R. 4E

Well No. 1 Pritz

Loriaux et al. Company

FIRST REPORT

Contractor \_\_\_\_\_

NE NW SW


SECTION PLAT

330 Ft. from N. Line

\_\_\_\_\_ Ft. from S. Line

\_\_\_\_\_ Ft. from E. Line

990 Ft. from W. Line

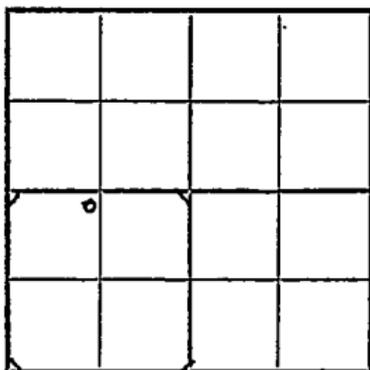

Marion County

Location X

Rig up \_\_\_\_\_

Drilling and Remarks:

RECORD

Cased \_\_\_\_\_ in., \_\_\_\_\_ ft.

Sand \_\_\_\_\_

Gas \_\_\_\_\_

Oil \_\_\_\_\_

Total Depth \_\_\_\_\_

PRODUCTION

1st 24 hrs. Nat: \_\_\_\_\_

1st 24 hrs. after shot \_\_\_\_\_

Gas \_\_\_\_\_ Cu. Ft.

Dry Hole \_\_\_\_\_

Abandoned \_\_\_\_\_

Date

SEP 29 1948 19

S. J. LEWIS Scout

Kansas

Map No. 26 Sec. 26 Twp. 17 R. 4EWell No. 1 PritzLoriaux etal. CompanyCOMPLETE Contractor

NE NW SW

## SECTION PLAT

330 Ft. from N. Line       Ft. from S. Line       Ft. from E. Line990 Ft. from W. Line

o			

Marion County

Location \_\_\_\_\_

Rig up \_\_\_\_\_

Drilling and Remarks:

*Miss 2321**5" @ 2326.**Pump Soil Pk**85° SW*

## RECORD

Cased \_\_\_\_\_ in., \_\_\_\_\_ ft.

Sand \_\_\_\_\_

Gas \_\_\_\_\_

Oil Total Depth 2374

## PRODUCTION

1st 24 hrs. Nat. \_\_\_\_\_

1st 24 hrs. after shot \_\_\_\_\_

Gas \_\_\_\_\_ Cu. Ft.

Dry Hole \_\_\_\_\_

Abandoned \_\_\_\_\_

Date

OCT 27 1948 19S. J. LEWIS Scout