

KANSAS

Marion

FORM 51 5M PETROL

Section 26 Township 17 Range 4-E

Well No. #2 Thompson

Company Oathout et al

							0

NORTH

WEST

EAST


SOUTH

KANSAS

Marion

Sec. 26 Twp. 17 R. 4-EWell No. #2 Thompson FarmOathout etal Company

NORTH

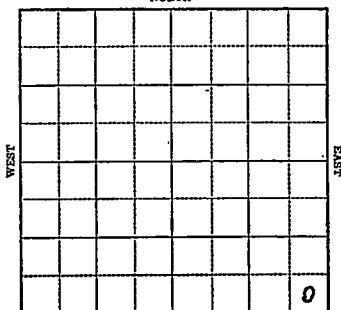

SOUTH

 Ft. from N. Line330 Ft. from S. Line330 Ft. from E. Line Ft. from W. LineElev. 1444

1943

R E P O R T

9/8

Cable

9/15

"

9/22

Spud

9/29

12" @ 198'
Drlg. 760'

10/6

10" @ 1017'
Drlg. 1470'

10/13

Lans 1768
8" @ 1768
Drlg. 1820

10/20

Drlg. 2000'

10/27

Miss 2290
6" @ 2302
Drlg. 2460'

11/3

Miss 2290
6" @ 2302
HFW
T.D. 2516'

ABANDONED

KANSAS

Map No. 26 Sec. 26 Twp. 17 R. 4EWell No. 2 ThompsonOathout etal

Company

FIRST REPORT

Contractor

SE/C

SECTION PLAT

			0

Ft. from N. Line

330

Ft. from S. Line

330

Ft. from E. Line

Ft. from W. Line

Lost Spring Pool

Location

Rig up

Drilling and Remarks:

Cable

RECORD

Cased _____ in., _____ ft.

Sand _____

Gas _____

Oil _____

Total Depth _____

PRODUCTION

1st 24 hrs. Nat. _____

1st 24 hrs. after shot _____

Gas _____ Cu. Ft.

Dry Hole _____

Abandoned _____

Date

SEP 8 1943 19

S. J. LEWIS Scout

no
but
R

M

Misc Small Maps	
Cards	<i>Beet</i>
Tracing	<i>ME</i>
France Map	<i>X</i>
Scarborough	<i>X</i>
Moody Map	<i>X</i>
Geological Dept.	
Moody Flat Book	


Map No. 26 Sec. 26 Twp. 17 R. 4E
 Well No. 2 Thompson

Oathout etal. Company

ABANDONED Contractor

SE/C

SECTION PLAT

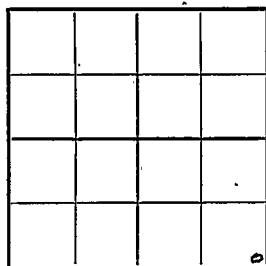

 Ft. from N. Line

330 Ft. from S. Line

330 Ft. from E. Line

 Ft. from W. Line

Lost Springs Pool

Location

Rig up

Drilling and Remarks:

Miss 2290

6°C 2302

HPW

RECORD

Cased in., ft.

Sand

Gas

Oil

Total Depth 2516

PRODUCTION

1st 24 hrs. Nat.

1st 24 hrs. after shot

Gas Cu. Ft.

Dry Hole

Abandoned

Date

NOV 3 1943 19 S. J. LEWIS Scout

no well

Misc. Small Maps

Cards

Tracing

France Map

Scarborough Map

Pierce Map

Geological Dept.

Water Dept.