


Section 27 Township 17 Range 4E

Well No. 1 Bevins (Bevans)

Company Augusta Oil et al

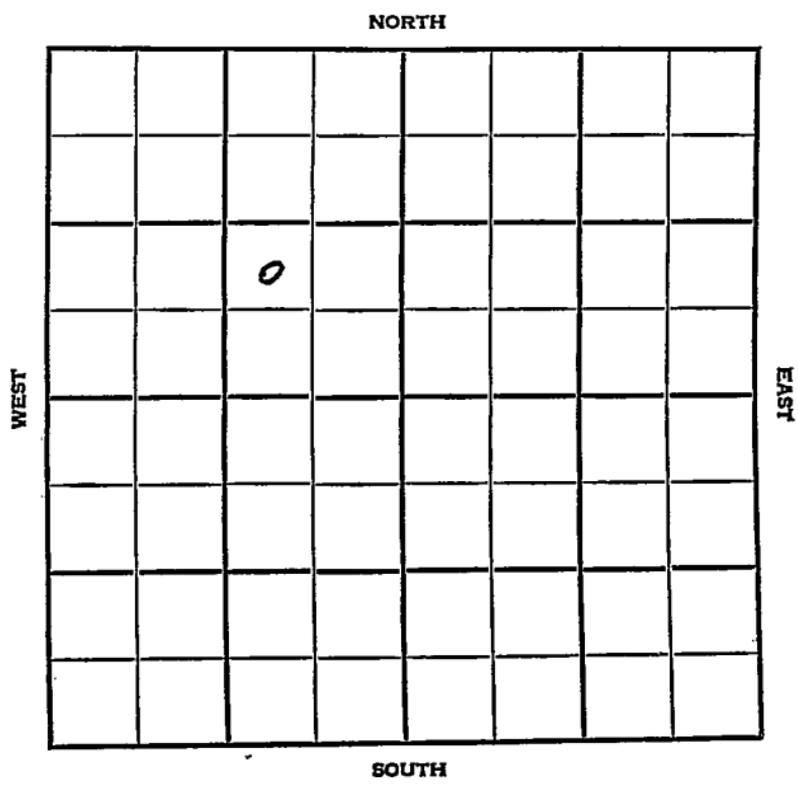

County Marion State Kansas

Sec. 27 (Blk. 17 (Sur. 4E (Twp. 17 (Rge. 4E Map No.

Operator Augusta Oil etal.

Well No. 1 Farm Bevins

Elev. 1482 Location NW SE NW

990Ft. From S Line NW

990Ft. From E Line Quarter

1st. Report

Completion JAN 19 1955

Remarks Lost Springs Pool

Spudding Date 12-28-54

Drlg. Data Oil well TD 2388

8" @ 118 Miss. 2378 TD 2386

4 1/2" @ 2381 DD 2388 FU 1200' oil 14 hr.

P/ 45 bopd 2 days Comp. 25 bopd

FABEN GILSTRAP