


Section 27 Township 17 Range 4E

Well No. #2 Lueker

Company Don Ingling et al

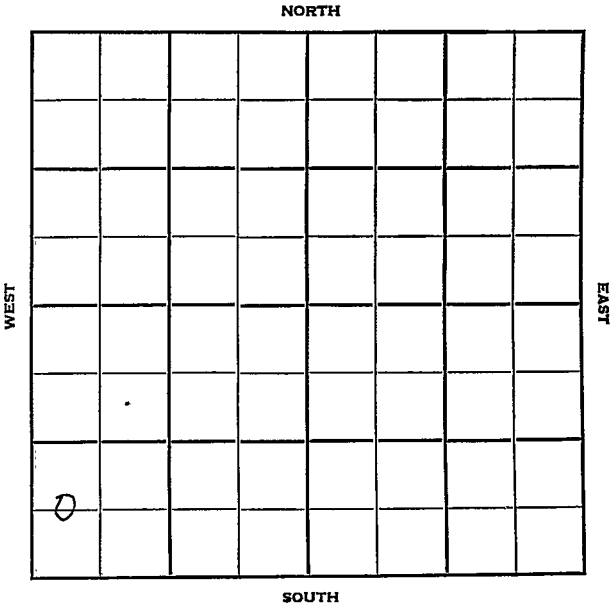

KANSAS

Marion

Sec. 27 Twp. 17 R. 4-E ✓

Well No. #2 Lueker Farm

Don Ingling et al Company

Lost Springs Pool Contractor


 Ft. from N. Line

660 Ft. from S. Line

 Ft. from E. Line

330 Ft. from W. Line

C W L SW SW

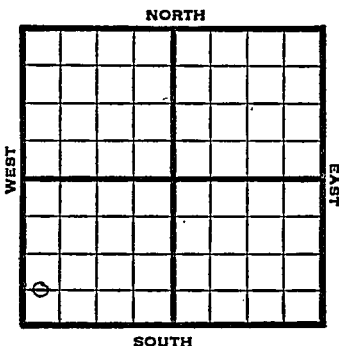


1950 Elev 1492 REPORT

10/11 Spud 10-5-50
8 5/8" @ 110
Dr1g 750

11/1 Spud 10-5-50
Oil Well TD 2442'
8-5/8" @ 110'
Chat 2387' TD 2398'
5" @ 2393'
DD 2442
Comp. 10 BOPD

COMPLETED

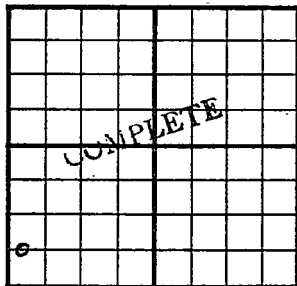County Marion State KansasSec. 27 (Blk.
Twp.) 17 (Sur.
Rge.) 4E Map No.Operator Don Ingling etal.Well No. 2 Farm LuekerElev. 1492 Location C W I. SW SW660 Ft. From S Line SW330 Ft. From W Line Quarter1st. ReportCompletion NOV 1 1950Remarks Lost Springs PoolSpudding Date 10-5-50Drilg. Data Oil well TD 24428 5/8" @ 110 Chat 2387 TD 23985" @ 2393 DD 2442 Comp. 10 bopd

J. E. TYRA