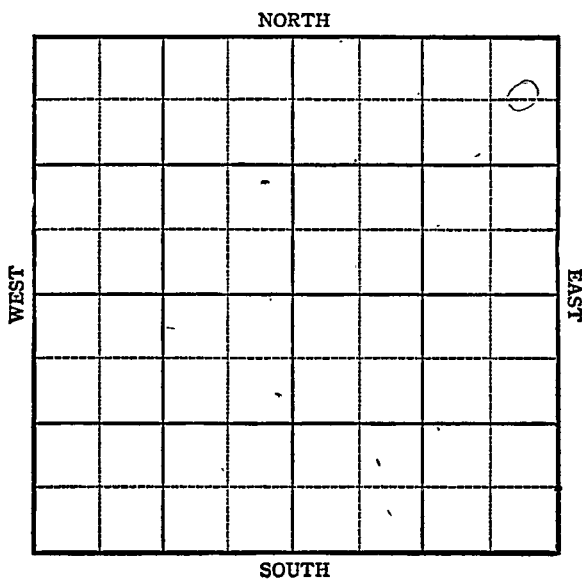


KANSAS

Marion

Section 27 Township 17 Range 4EWell No. #5 MeyersCompany Sunflower Oil

KANSAS

Marion County

Sec. 27 Twp. 17 R. 4EWell No. #5 Meyer FarmSunflower Oil Company

Lost Spring

NORTH

660 Ft. from N. Line Ft. from S. Line330 Ft. from E. Line Ft. from W. Line

WEST

EAST

SOUTH

C E L N E N E

1944

REPORT

8/16 Machine

8/23 Apud

8/30 12" @ 118

Drlg. 715

9/8 Drlg. 1060

10" @ 1020

9/13 8" @ 1508' Drlg. 1850

9/21 Drlg. 2060

9/28 Miss 2347-50 TD

5" @ 2350 WOC

10/4 TD 2406- 60' oil

10/11 Miss 2347'

5" @ 2350'

TD 2406'

Pump 10 Pot.

36.0 Gravity

KANSAS

Marion County

Sec. 27 Twp. 17 R. 4E

Well No. #5, Meyers Farm

Sunflower Oil Company


Lost Springs

1250 Ft. from N. Line

 Ft. from S. Line

330 Ft. from E. Line

 Ft. from W. Line

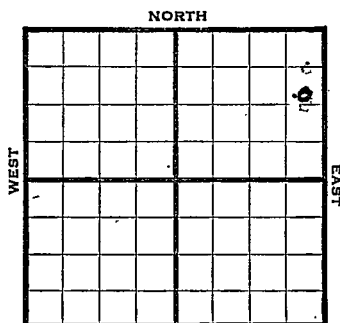

SOUTH
C E L E $\frac{1}{2}$ NE

1944

REPORT

8-30

Location

Pool Name Lost Spring


KANSAS
 Map No. 26 Sec. 22 Twp. 17 R. 4E

Well No. 5 Meyer
Sunflower Oil Company

FIRST REPORT Contractor

C E L N E N E

SECTION PLAT

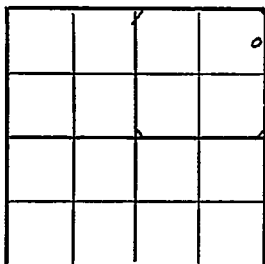660 Ft. from N. Line Ft. from S. Line330 Ft. from E. Line Ft. from W. Line

Marion

Location Rig up

Drilling and Remarks:

Machine

RECORD

Cased in., ft.Sand Gas Oil Total Depth

PRODUCTION

1st 24 hrs. Nat. 1st 24 hrs. after shot Gas Cu. Ft.Dry Hole Abandoned

Date

AUG 16 1944 19 S. J. LEWIS Scout

no. *Wm. M. M.*

Misc. Small Maps

Cards

Tracing

France Map

Scarborough A

Moody Map

Geological Dept

Moody Plat Book

Pool Name Lost Spring

KANSAS

Map No. 26 Sec. 27 Twp. 17 R. 4EWell No. 5 MeyerSunflower Oil Company
CORRECTION

Contractor

~~C E L E N E~~

SECTION PLAT

1250 Ft. from N. Line Ft. from S. Line330 Ft. from E. Line Ft. from W. Line*FIRST*

Marion

Location

Rig up

Drilling and Remarks:

Reported

C E L E N E

RECORD

Cased in., ft.Sand Gas Oil Total Depth

PRODUCTION

1st 24 hrs. Nat. 1st 24 hrs. after shot Gas Cu. Ft.Dry Hole Abandoned

Date

AUG 30 1944

19

S. J. LEWIS Scout

no wall not

Misc Small Maps.

r yrd

11


1944 1st Mep



Week 11 Dec

Pool Name Lost SpringMap No. 26 Sec. 27 Twp. 17 R. 4EWell No. 5 MeyerSunflower Oil CompanyCOMPLETED

Contractor

C E L E $\frac{1}{2}$ NE

SECTION PLAT

1250 Ft. from N. Line

_____ Ft. from S. Line

330 Ft. from E. Line

_____ Ft. from W. Line

Marion County

Location _____

Rig up _____

Drilling and Remarks:

*Size 2347**5' 10" 2350**Pump 10 P.S.**362 Lbs*

RECORD

Cased _____ in., _____ ft.

Sand _____

Gas _____

Oil _____

Total Depth 2406

PRODUCTION

1st 24 hrs. Nat. _____

1st 24 hrs. after shot _____

Gas _____ Cu. Ft.

Dry Hole _____

Abandoned _____

Date

OCT 11 1944 19S. J. LEWIS Scout

new world map

Misc Small Maps	L Reid
Cards	Betty
Tre Map	B. H.
Tronco Map	✓
Scarborough Map	L Reid
Moody Map	✓
Geological Dept.	
Moody Plat Book	