


Section 27 Township 17 Range 4E

Well No. #7 Meyers

Company Four L.

NORTH

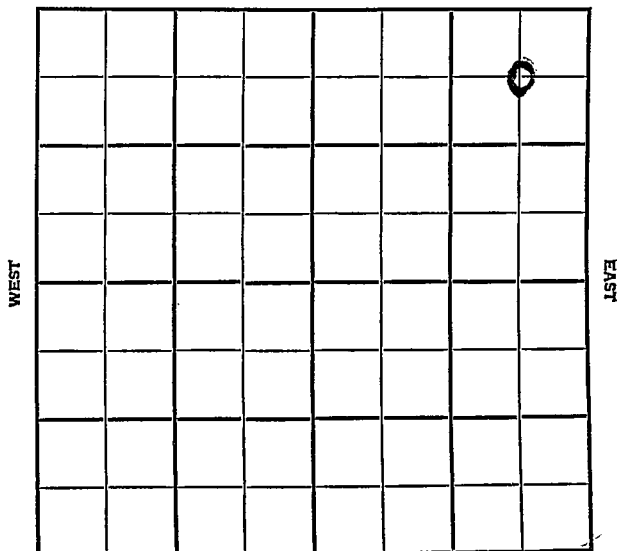

SOUTH

Marion

KANSAS

SEC.

27

TWP.

17

R.

4E

#7 NO.

Meyer

FARM

COMPANY

A.M.F.A. Four L

CONTRACTOR

Slusser

Lost Springs


660 Ft. from N. Line

Ft. from S. Line

660 Ft. from E. Line

Ft. from W. Line

C NE NE

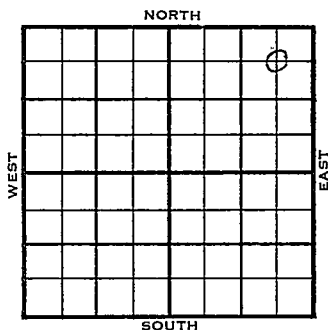

1955

ELEVATION

1456

REPORT

6/29

Location

7/27

Comm. 7-6-55

8 5/8" @205/160 5 1/2" @2628 CO to 2686

Comp. SWD well.

M. Li. 2346 890

M. Base 2394 938

Hunt 2621 1165

TD. 2686

COMPLETED

County Marion Elev. _____
 Sec. 27 Twp. 17 Rge. 4E
 Company A.M.F.A.
 Farm Name Meyer No. I

TOPS	DEPTH	LOG	DATUM
Anh.			
TP.			
H.			
Tr.			
Dg.			
BL.			
L.			
K.C.			
B.K.C.			
Ce.			
C.			
M.			
M.			
K.			
Mz.			
Me.			
V.			
S.			
S.			
A.			
R.			
Pe.			
G.			
T.D.			

Loc. in Sec. _____

C NE NE

Geol. _____

Contr. _____

Slusser

Pool _____

Lost Springs

			0
JUN 29	35		
FIRST	REPORT		

Date Comm. _____

Location

Co.

Lse.

No.

Sec.

T.

R.

JUL 1 1955

Scout Cards	<i>mmc</i>
Land Small Map	
Land Wall Map	
Tracings	
France Map	
Pierce Map	
Misc.	

SCOUT TICKET

DX-201

Kansas

SEC.

27

TWP.

17

R.

4E

WELL NO.

1 Meyer

FARM

COMPANY

Four L

CONTRACTOR

CORRECTION

C NE NE

660


FT. FROM N. LINE

FT. FROM S. LINE

660

FT. FORM E. LINE

FT. FROM W. LINE

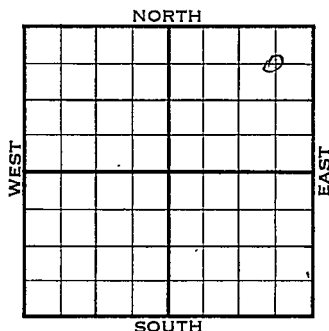

Marion County

☐

LOCATION

☐

RIG UP

DRILLING AND REMARKS:

Reported

A.M.F.A.

RECORD

CASED IN., FT.

SAND

GAS

OIL

TOTAL DEPTH

1ST 24 HRS. NAT.

1ST 24 HRS. AFTER SHOT

GAS CU. FT.

DRY HOLE

ABANDONED

PRODUCTION

DATE

JUL 6 1955

SCOUT

L. J. Harris

1000000

Scout Cards	<i>mm</i>
Land Small Map	_____
Land Wall Map	_____
Tracings	_____
France Map	_____
Pierce Map	_____
Misc.	_____

JUL 11 1955

SCOUT TICKET

DX-201

Kansas

SEC.

27

TWP.

17

R.

4E

WELL NO.

7 Meyer

FARM

COMPANY

Four L

CONTRACTOR

CORRECTION

C NE NE

660

FT. FROM N. LINE


FT. FROM S. LINE

660

FT. FORM E. LINE

FT. FROM W. LINE

NORTH

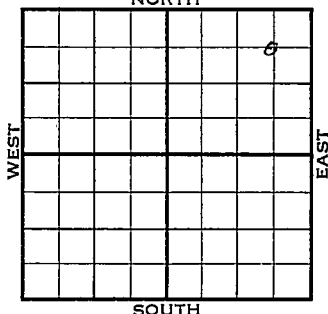

Marion County

☐

LOCATION

☐

RIG UP

DRILLING AND REMARKS:

Reported
#1 Meyer

RECORD

CASED IN., FT.

SAND

GAS

OIL

TOTAL DEPTH

1ST 24 HRS. NAT.

1ST 24 HRS. AFTER SHOT

GAS CU. FT.

DRY HOLE

ABANDONED

PRODUCTION

DATE

JUL 20 1955

SCOUT

L. J. Harris

NOIT 32. 1-2

Scout Cards	<i>mm</i>
Land Small Map	_____
Land Wall Map	_____
Tracings	_____
France Map	_____
Pierce Map	_____
Misc.	_____

JUL 26 1955

County Marion Elev. 1456Sec. 27 Twp. 17 Rgs. 4ECompany Four LFarm Name Meyer No. 7

TOPS

DEPTH

LOG

DATUM

Loc. in Sec.

C NE NE

Anb.

Tp.

H.

Tr.

Dg.

Bl.

L.

K.C.

B.K.C.

Ce.

C.

M.

M.

K.

Mz.

Mq.

V.

S.

S.

A.

R.

P.E.

G.

T.D.

Geol.

Contr.

Slusser

Pool

Lost Springs

ABANDONED

Date Comm. 7-6-55

JUL 27 1955

8 5/8" @ 205/160 5 1/2" @ 2628CO to 2686 Comp. SWD well

AUG 14 1955

Scout Cards	JC
Land Small Map	
Land Wall Map	
Tracings	
Picture Map	
Picture Map	
Misc.	