

C.W.W.O.

KANSAS


Marion

Section 27 Township 17 Range 4E

Well No. #1 Pritz

Company Tomlin + Kathol
~~Veeder Supply~~ Lost Spring

Lost Spring NORTH

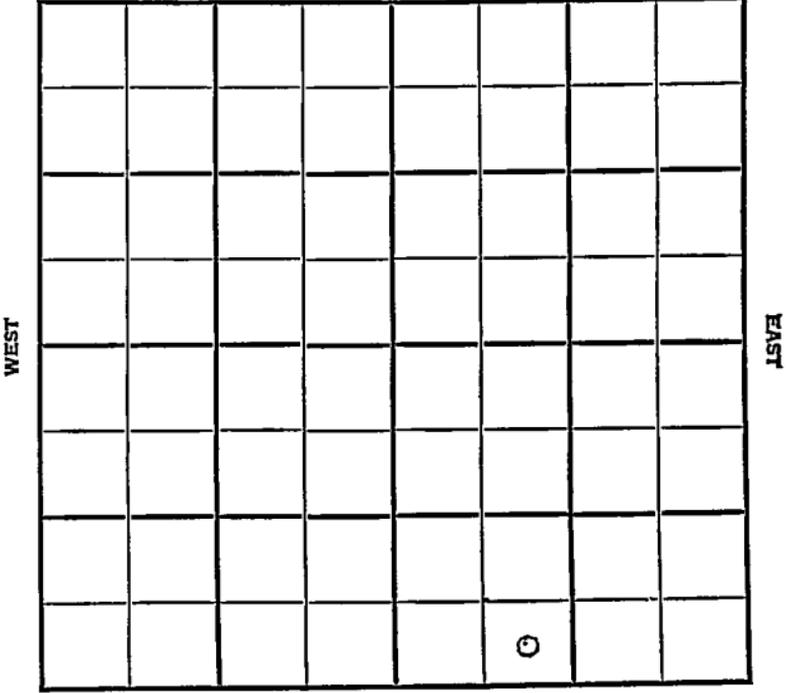

SOUTH

KANSAS

Marion

Sec. 27 Twp. 17 R. 4E

Well No. #1 Pritz Farm

Veeder Supply Company

Lost Spring


_____ Ft. from N. Line

330' Ft. from S. Line

_____ Ft. from E. Line

990' Ft. from W. Line

SE SW SE

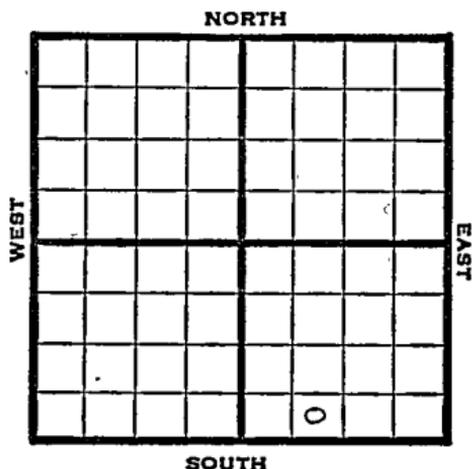

1948

Elev. 1472' REPORT

3/31 8" @ 142'
Miss. 2346'
TD 2349'
Run csg.

4/7 5" @ 2349'
RUST

4/14 "

4/21 "

4/28 TD 2390'

5/5 "

5/12 "

5/19 "

5/26 "

6/1 "

6/9 Miss. 2346'
5" @ 2349'
Pump 10 Pot
36.0 Gr.
TD 2390'
Compl

COMPLETED

Map No. _____ Sec. 27 Twp. 17 R. 4EWell No. 1 Pritz_____ Veeder Supply _____ Company

FIRST REPORT

_____ Contractor

SE SW SE

SECTION PLAT

_____ Ft. from N. Line

330 Ft. from S. Line

_____ Ft. from E. Line

990 Ft. from W. Line

Marion County

RECORD

Location _____

Cased _____ in., _____ ft.

Rig up _____

Sand _____

Drilling and Remarks:

Gas _____

8" @ 142

Oil _____

Miss. 2346

Total Depth _____

TD 2349

PRODUCTION

Run csg.

1st 24 hrs. Nat. _____

1st 24 hrs. after shot _____

Gas _____ Cu. Ft.

Dry Hole _____

Abandoned _____

Date

MAR 31 1948 19S. J. LEWIS Scout

O.W.W.O.

FORM 513 SUNRAY

County Marion Elev. 1472 Co.
 Sec. 27 Twp. 17 Rgs. 4E
 Company Bert Young
 FarmName Pritz No. 1

TOPS	DEPTH	LOG	DATUM	Loc. in Sec.
Anh.				SE SW SE
TP.				
H.				OWWO
Tr.				
Dg.				
Bl.				
L.				Geol. <u> </u>
K.C.				Contr. <u> </u>
B.K.C.				
Ce.				
C.	2346			
M.				
M.				Pool
K.				Lost Springs
Mz.				
Me.				
V.				
S.				
S.				BEST REPORT
A.				
R.				
PE.				JAN 3 '77
G.				
FD.	2390			o

Date Comm. 5" @ 2351 CO

[Handwritten signature]

Co. Lse. No. Sec. T. R.

CORRECTION

FORM 513 SUNRAY

County	Marion	Elev.	1172 "
Sec.	27	Twp.	17
		Rgs.	4E
Company	Bert Young Tomlin & Kathol		
Farm Name	Pritz		No. 1

TOPS	DEPTH	LOG	DATUM	Loc. in Sec.				
Anb.				SE SW SE				
Tr.				ONE				
Dg.								
Bl.								
L.				Geol.				
K.C.				Contr.				
B.K.C.								
Ce.								
C.	2346							
M.				Pool				
M.				Lost Springs				
K.								
Mz.								
Mo.								
V.								
S.								
S.								
A.								
R.								
PE.								
G.								
J.D.	2390			<table border="1" style="width: 100%; height: 100px;"> <tr> <td colspan="2" style="text-align: center; font-size: 2em;">COMPLETE</td> </tr> <tr> <td colspan="2" style="text-align: center;">FEB 27 '57</td> </tr> </table>	COMPLETE		FEB 27 '57	
COMPLETE								
FEB 27 '57								

Date Comm. 50 @ 2351 - CO IN 9" CO 2352
 4 1/2 @ 2750/75 CO IN 12" T
 JAN 29 '57 17 in. JAN 1 '57 17 in FEB 6 '57 17 in
 FEB 13 '57 FEB 20 '57 ✓ ~~7 Bopd~~
 : 27 '57 CO 2352 F12c 20 x 10
 P. 59 Bopd + 1 BW P.
 25 Bopd + Trace wtr

Co. Lsc. No. Sec. T. R.