


Section 27 Township 17 Range 5E

Well No. #1 Peterson

Company Mouser et al

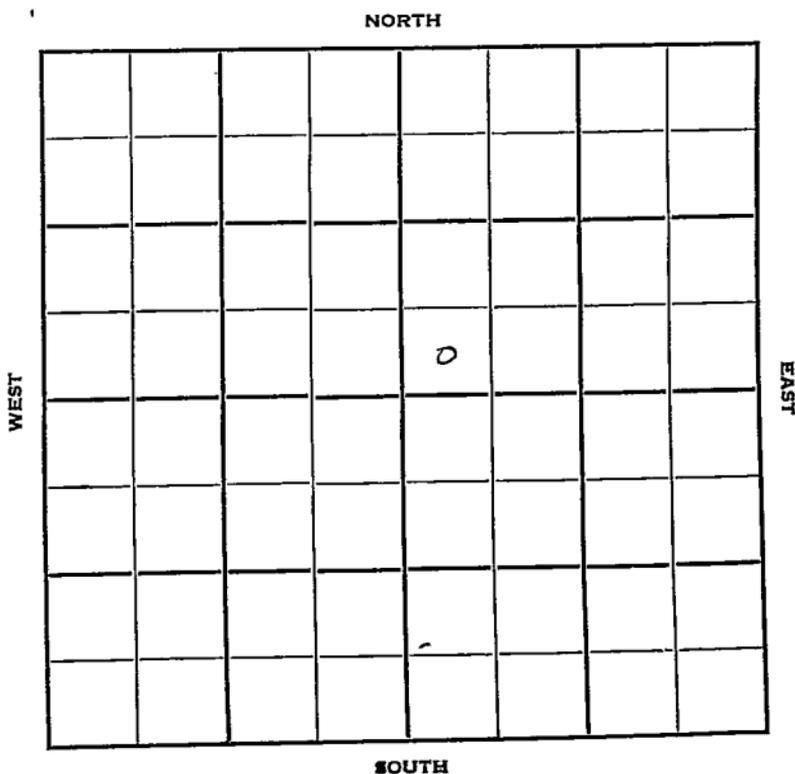

Sec. 27 Twp. 17 R. 5E

Well No. #1 Peterson Farm

Mouser et al Company

Mouser Drlg. Contractor

Wildcat


\_\_\_\_\_ Ft. from N. Line

330' \_\_\_\_\_ Ft. from S. Line

\_\_\_\_\_ Ft. from E. Line

330' \_\_\_\_\_ Ft. from W. Line

SW NE

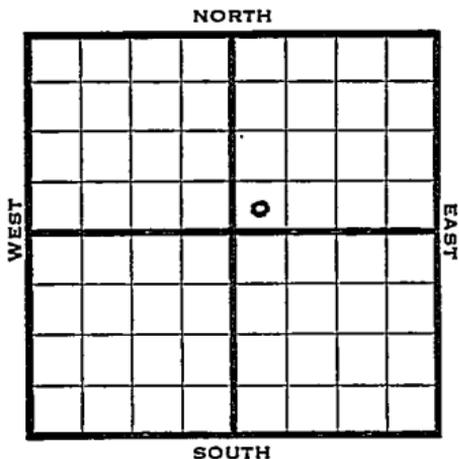

1949

Elev 1500'

REPORT

11/2

Location

11/9

RUR

11/16

8"@ 164'

Drlg 1619'

11/23

KC 1736'

Miss 2213-

5"@ 2214'

TD 2238'

"

11/29

TD 2406'

12/7

Miss 2213'

Aband.

**ABANDONED**

Kansas

Map No. \_\_\_\_\_ Sec. 27 Twp. 17 R. 5E

Well No. I Peterson

Mouser etal. \_\_\_\_\_ Company

Mouser Drlg. \_\_\_\_\_ Contractor

SW NE


FIRST REPORT  
SECTION PLAT

\_\_\_\_\_ Ft. from N. Line

330 Ft. from S. Line

\_\_\_\_\_ Ft. from E. Line

330 Ft. from W. Line

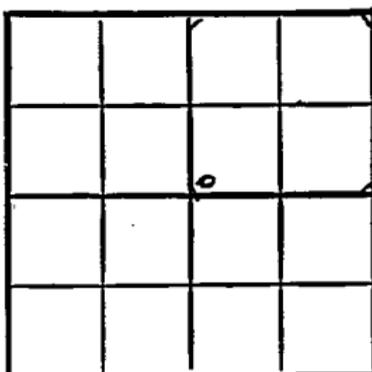

Morris County

Location X

Rig up \_\_\_\_\_

Drilling and Remarks:

RECORD

Cased \_\_\_\_\_ in., \_\_\_\_\_ ft.

Sand \_\_\_\_\_

Gas \_\_\_\_\_

Oil \_\_\_\_\_

Total Depth \_\_\_\_\_

PRODUCTION

1st 24 hrs. Nat. \_\_\_\_\_

1st 24 hrs. after shot \_\_\_\_\_

Gas \_\_\_\_\_ Cu. Ft.

Dry Hole \_\_\_\_\_

Abandoned \_\_\_\_\_

Date

NOV 2 1949

S. J. LEWIS

Scout

Map No. \_\_\_\_\_ Sec. 27 Twp. 17 R. 5E

Well No. 1 Peterson

Mouser et al. Company

**ABANDONED**

Contractor

SW NE

*El. 1500*

SECTION PLAT

\_\_\_\_\_ Ft. from N. Line

330 Ft. from S. Line

\_\_\_\_\_ Ft. from E. Line

330 Ft. from W. Line

|  |  |   |  |
|--|--|---|--|
|  |  |   |  |
|  |  |   |  |
|  |  | o |  |
|  |  |   |  |
|  |  |   |  |

Morris County

Location \_\_\_\_\_

Rig up \_\_\_\_\_

Drilling and Remarks:

*Misc 2213*

**RECORD**

Cased \_\_\_\_\_ in., \_\_\_\_\_ ft.

Sand \_\_\_\_\_

Gas \_\_\_\_\_

Oil \_\_\_\_\_

Total Depth 2406

**PRODUCTION**

1st 24 hrs. Nat. \_\_\_\_\_

1st 24 hrs. after shot \_\_\_\_\_

Gas \_\_\_\_\_ Cu. Ft.

Dry Hole \_\_\_\_\_

Abandoned \_\_\_\_\_

Date

DEC 7 1949 19

S. J. LEWIS Scout