


KANSAS

Form 51-5M-7-39-Palace

Section 28 Township 17 Range 4-E

Well No. #1 Houser

Company Streeter et al

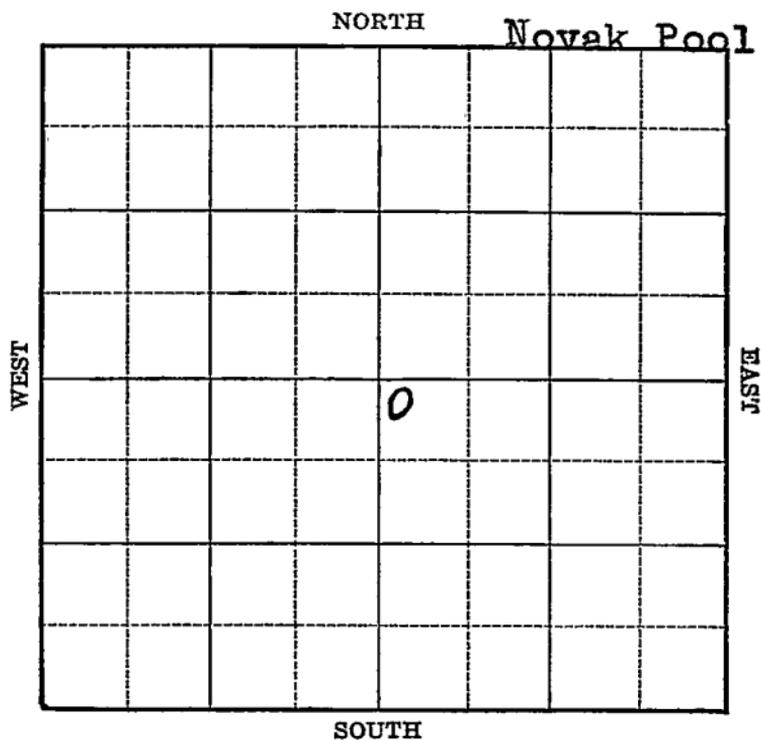

Sec. 28 Twp. 17 R. 4-E

Well No. #1 Houser (Twin well) Farm

Streeter et al Company

(Novak)


150 Ft. from N. Line

_____ Ft. from S. Line

_____ Ft. from E. Line

150 Ft. from W. Line

Elev. 1489

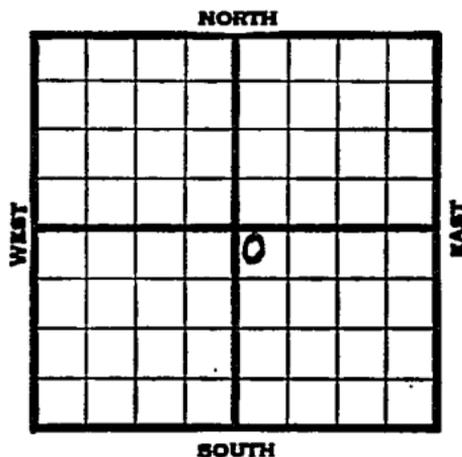

1939	REPORT
9/20	Machine.
9/28	12" - 108' Drlg. 475'
10/5	Drlg. 1190'
10/12	10" - 1585' Drlg. 1965'
10/19	SD 2300'
10/26	8" - 2060' Chat. 2427'
	T.D. 2450' 200' oil 2 hours.
	6" - 2427' WOC.
11/1	Chat. 2060'
	8" - 2060'
	6" - 2427'
	T.D. 2458'
	Pump 150 bbls.
	COMPLETED

Map No. 26 Sec. 28 Twp. 17 R. 4E

Well No. 1 Houser *Twin well*

Streeter etal Company

Contractor

FIRST REPORT

NW SE

SECTION PLAT

		o	

150 Ft. from N. Line

_____ Ft. from S. Line

_____ Ft. from E. Line

150 Ft. from W. Line

NOVAK POOL

Location _____

Rig up _____

Drilling and Remarks:

Machine

RECORD

Cased _____ in., _____ ft.

Sand _____

Gas _____

Oil _____

Total Depth _____

PRODUCTION

1st 24 hrs. Nat. _____

1st 24 hrs. after shot _____

Gas _____ Cu. Ft.

Dry Hole _____

Abandoned _____

Date

SEP 20 1939 19

S. I. NEW

Scout

Sandy: Is this a twin well? We show a
dry hole 330 from NL & 330 from WL drilled
by Lassen to T.D. 2477 Don Schumaker.

Misc. Small Maps	<i>BAM</i>
Cards	<i>Paul</i>
Tracing	<i>Jim</i>
Files	<i>X</i>
Mag	<i>X</i>

Map No. 26 Sec. 28 Twp. 17 R. 4EWell No. 1 Houser (Twin Well)Streeter etal

Company

Contractor

COMPLETED

NW SE

150 Ft. from N. Line Ft. from S. Line Ft. from E. Line150 Ft. from W. Line

NOVAK POOL

SECTION PLAT

		o	

Location _____

Rig up _____

Drilling and Remarks:

*Chas 2060**8" C 2060**6" C 2427**150 Hk Pump.*

RECORD

Cased _____ in., _____ ft.

Sand _____

Gas _____

Oil _____

Total Depth 2458'

PRODUCTION

1st 24 hrs. Nat. _____

1st 24 hrs. after shot _____

Gas _____ Cu. Ft.

Dry Hole _____

Abandoned _____

Date

NOV 1 1939 19

S. J. LEWIS Scout

RAY
Ray
Joe
X