

KANSAS


Form 51-5M-7-40-Palace

Marion

Section 28 Township 17 Range 4-E

Well No. #2 Hauser

Company Hauser & Adams

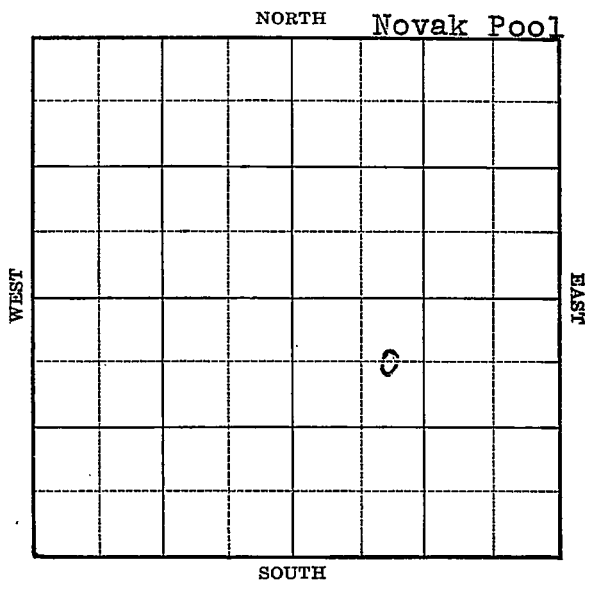

Sec. 28 Twp. 17 R. 4-E

Well No. #2 Hauser Farm
Hauser & Adams Company


(Navak)

660 Ft. from N. Line

_____ Ft. from S. Line

_____ Ft. from E. Line

990 Ft. from W. Line

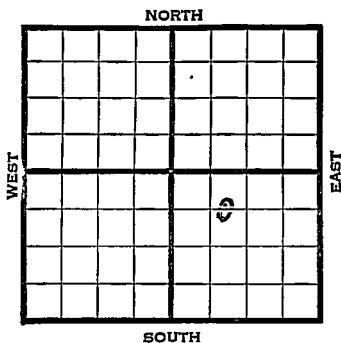

Elev. 1496

1940	REPORT
9/25	15" - 90'
	Drlg. 600'
10/3	15" - 110' 12" - 875'
	Drlg. 1450'
10/10	10" - 1585' 8" - 1853'
	Drlg. 1913'
10/17	Miss. 2398' 7" - 2402'
	T.D. 2407' 1000' oil.
10/24	T.D. 2431' 2300' oil 8 hrs.
	P.B.P.
10/30	Miss. 2398'
	7" - 2402'
	T.D. 2431'
	Potential 474 bbls., pump.
	COMPLETED

Map No. 26 Sec. 28 Twp. 17 R. 4EWell No. 2 HauserHauser & Adams

Company

Contractor

FIRST REPORT

C E L NW SE

660 Ft. from N. Line

_____ Ft. from S. Line

_____ Ft. from E. Line

990 Ft. from W. Line

NOVAK POOL

SECTION PLAT

Location _____

Rig up _____

Drilling and Remarks:

15" - 90Drig. 600

RECORD

Cased _____ in., _____ ft.

Sand _____

Gas _____

Oil _____

Total Depth _____

PRODUCTION

1st 24 hrs. Nat. _____

1st 24 hrs. after shot _____

Gas _____ Cu. Ft.

Dry Hole _____

Abandoned _____

Date

SEP 25 1940 19S. J. LEWIS Scout

Misc Small Maps	
Cards	<i>Paul</i>
Tracing	<i>JRC</i>
France Map	<i>—</i>
rough Map	<i>X</i>
body Map	<i>—</i>
Geological Dept.	
Moddy Lat Book	

Misc Small Maps	<i>DMS</i>
Cards	<i>Paul</i>
Tracing	<i>JM</i>
Reference Map	
Scarborough Map	<i>X</i>
Moody Map	<i>X</i>
Geological Dept.	
Moody Flat Book	