

Marion


KANSAS

SECTION 28 TOWNSHIP 17 RANGE 4 E

WELL NO. #8 Hauser "A"

COMPANY Hauser & Adams

NORTH

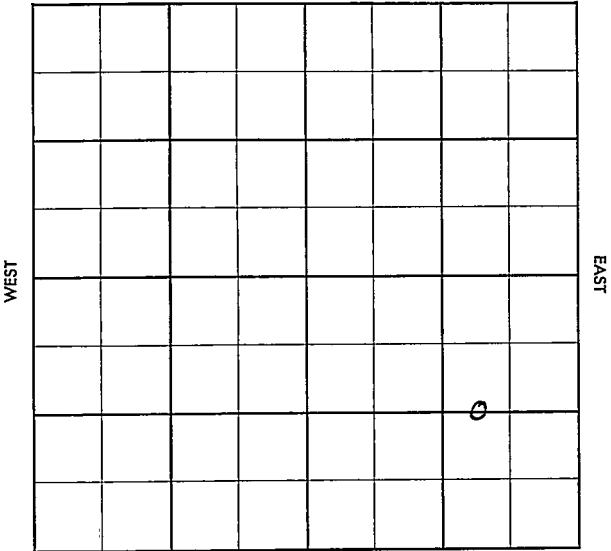

SOUTH

Marion

KANSAS

SEC.	TWP.	R.
28	17	4E

WELL NO.

#8 Hauser "A"

FARM

COMPANY

Hauser & Adams

CONTRACTOR

Slusser


Lost Springs

Ft. from N. Line

Ft. from S. Line

Ft. from E. Line

Ft. from W. Line

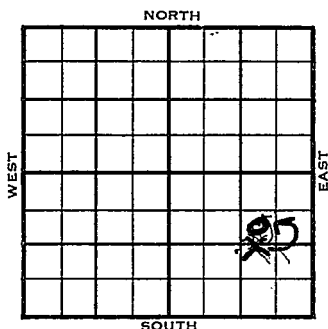~~C W $\frac{1}{2}$ E $\frac{1}{2}$ SE~~

SW NE SE

1956

ELEVATION

REPORT

2-1

Comm. 1-27-56

8" @ 108/65

Drlg. 1920

#

3-21

5 $\frac{1}{2}$ " @ 2398/300

DD 2405

S/ 5 boph

DD 2408,

S/ 7 boph

COMP. 175 bopd

M. 2396

TD 2400'

COMPLETED

CORRECTION

FORM 513 REV. SUNRAY

 Sec. 28 Twp. 17 Rge. 4E
 Company Hauser & Adams
 Farm Name Hauser "A" No. 8

TOPS	DEPTH	LOG	DATUM	Loc. in Sec.
Anh.				SW NE SE
Tr.				
Dg.				
Bl.				
L.				
K.C.				Geol.
B.K.C.				Contr.
Ce.				
C.				
M.				Pool
K.				
Mz.				
Me.				
V.				
S.				
S.				
A				
R.				
Pe.				
G.				
T.D.				

CORRECTION

Date Comm.

MAR 21 1956

Reported C W $\frac{1}{2}$ E $\frac{1}{2}$ SE

County Marion Elev. _____
 Sec. 28 17 Rge. 4E
 Company Hauser & Adams
 Farm Name Hauser "A" No. 8

TOPS	DEPTH	LOG	DATUM	Loc. in Sec.
Anh.				SW NE SE
Tr.				
H.				
Tr.				
Dg.				
BL.				
L.				Geol.
K.C.				Contr.
B.K.C.				Slusser
Ce.				
C.				Pool
M.	2396			Lost Springs
M.				
K.				
Mz.				
Me.				
V.				
S.				
S.				
A.				
R.				
Pe.				
G.				
T.D.	2400			

COMPLETE

Date Comm. 1-27-56 MAR 21 1956

8" @ 108/65 5 $\frac{1}{2}$ " @ 2398/30 DD 2405

S/ 5 boph DD 2408 S/ 7 boph

Comp. 175 bopd