

KANSAS

Marion


Section 28 Township 17 Range 4EWell No. #6 HauserCompany Hauser & Adams

Lost Spring

NORTH

WEST

EAST

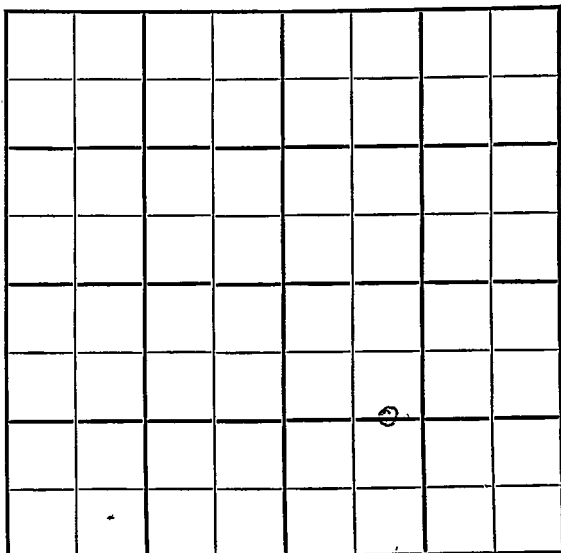

SOUTH

KANSAS Marion

Sec. 28 Twp. 17 R. 4E

Well No. #6 Hauser Farm

Hauser & Adams Company

Lost Spring


1320 Ft. from N. Line

Ft. from S. Line

Ft. from E. Line

990 Ft. from W. Line

C E L $W\frac{1}{2}$ SE

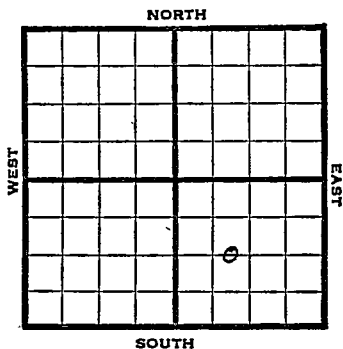

1947 Elev. 1499' REPORT

12/3 Machine.

12/10 "

12/17 "

12/30 12" @ 108'
Drlg. 200'

1948
1/7 SD

1/14 10" @ 975'
Drlg 1182'

1/21 8" @ 1785'
CO

1/26 "

2/4 "

2/11 Mississippi 2395'
TD 2404'
6" @ 2402'
RUST

2/18 Miss. 2395'
6" @ 2402'
Pump 70 Pot
Gr. 38.0
TD 2407'
Comp.

COMPLETED

Map No. _____ Sec. 28 Twp. 17 R. 4E

Well No. 6 Hauser

Hauser & Adams Company

FIRST REPORT Contractor

C E L W $\frac{1}{2}$ SE


SECTION PLAT

1320 Ft. from N. Line

_____ Ft. from S. Line

_____ Ft. from E. Line

990 Ft. from W. Line

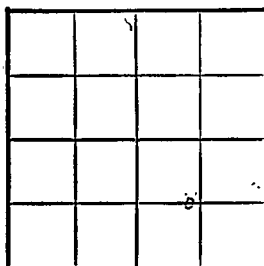

Marion County

Location _____

Rig up _____

Drilling and Remarks:

Machine

RECORD

Cased _____ in., _____ ft.

Sand _____

Gas _____

Oil _____

Total Depth _____

PRODUCTION

1st 24 hrs. Nat. _____

1st 24 hrs. after shot _____

Gas _____ Cu. Ft.

Dry Hole _____

Abandoned _____

Date

DEC 3 1947 19 S. J. LEWIS Scout


Kansas

Map No. 26 Sec. 28 Twp. 17 R. 4EWell No. 6 HauserHauser & Adams

Company

COMPLETE

Contractor

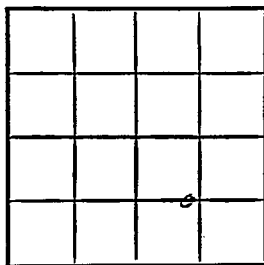C E L W $\frac{1}{2}$ SEE114??
SECTION PLAT1320 Ft. from N. Line Ft. from S. Line Ft. from E. Line990 Ft. from W. LineMarion CountyLocation Rig up

Drilling and Remarks:

Wire 23956" @ 2402Run 70 Rod8826

RECORD

Cased in., ft.Sand Gas Oil Total Depth 2407

PRODUCTION

1st 24 hrs. Nat. 1st 24 hrs. after shot Gas Cu. Ft.Dry Hole Abandoned

Date

FEB 18 1948

19

S. J. LEWIS

Scout