


Section 28 Township 17 Range 4-E

Well No. #3 Novak

Company Harwood Oil

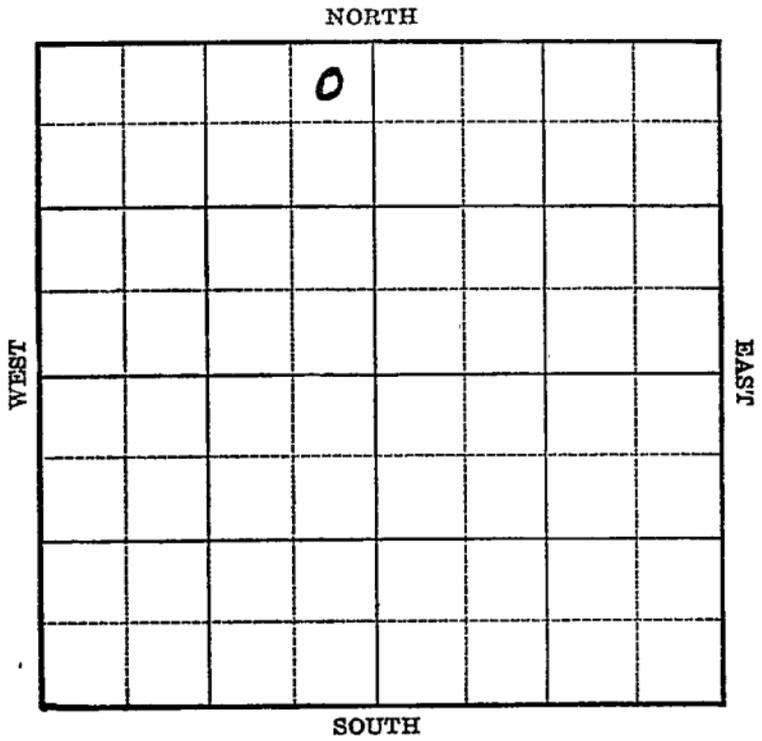



Map No. 26 Sec. 28 Twp. 17 R. 4E

Well No. 3 Novak

Harwood Oil Company

Contractor

**FIRST REPORT**

**NE NW**

330 Ft. from N. Line

\_\_\_\_\_ Ft. from S. Line

330 Ft. from E. Line

\_\_\_\_\_ Ft. from W. Line

**SECTION PLAT**


**NOVAK POOL**

Location X

Rig up \_\_\_\_\_

Drilling and Remarks:

**RECORD**

Cased \_\_\_\_\_ in., \_\_\_\_\_ ft.

Sand \_\_\_\_\_

Gas \_\_\_\_\_

Oil \_\_\_\_\_

Total Depth \_\_\_\_\_

**PRODUCTION**

1st 24 hrs. Nat. \_\_\_\_\_

1st 24 hrs. after shot \_\_\_\_\_

Gas ✓ \_\_\_\_\_ Cu. Ft.

Dry Hole \_\_\_\_\_

Abandoned \_\_\_\_\_

Date

MAY 10 1939

19

S. J. LEWIS

Scout

Misc Small Maps *Handwritten scribble*  
Cards *Handwritten scribble*  
Tracing *Job*  
France Map *Handwritten scribble*  
Scarborough Map *X*  
Moody Map .....  
Geological Dept. ....  
Moody Flat Book .....

Map No. .26 Sec. 28 Twp. 17 R. 4EWell No. 3 NovakHarwood Oil

Company

Contractor

**COMPLETED****NE NW**330 Ft. from N. Line

\_\_\_\_\_ Ft. from S. Line

330 Ft. from E. Line

\_\_\_\_\_ Ft. from W. Line

**NOVAK POOL****SECTION PLAT**

	0		

Location \_\_\_\_\_

Rig up \_\_\_\_\_

Drilling and Remarks:

*Miss 2388*  
*6" @ 2388*

*Pump 240*

**RECORD**

Cased \_\_\_\_\_ in., \_\_\_\_\_ ft.

Sand \_\_\_\_\_

Gas \_\_\_\_\_

Oil \_\_\_\_\_

Total Depth 2413**PRODUCTION**

1st 24 hrs. Nat. \_\_\_\_\_

1st 24 hrs. after shot \_\_\_\_\_

Gas \_\_\_\_\_ Cu. Ft.

Dry Hole \_\_\_\_\_

Abandoned \_\_\_\_\_

Date

SEP 20 1939 19S. J. LEWIS Scout

Misc Small Maps

Cards

Tracing

*Part*  
*Part*  
*Part*  
*Part*