

# KANSAS


Form 51-5M-7-40-Palace

Marion

Section 28 Township 17 Range 4-E

Well No. #7 Novak

Company Harwood Oil et al

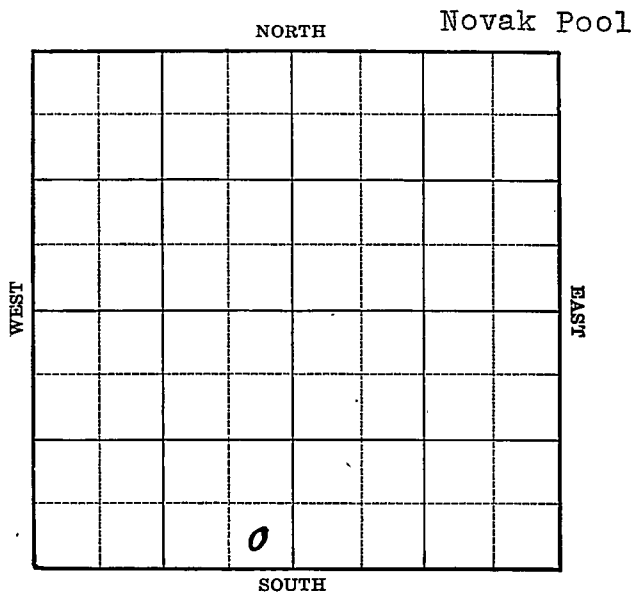



1941  
3/5

Miss. 2403'  
5" - 2405'  
T.D. 2439'  
Potential 164 bbls ., pump.  
36.7 Gravity

COMPLETED



Misc. Small Maps

Cards

Tracing

France Map

Scarborough Map

Moody Map

Geological Dept.

Moody Flat Book

Map No. 26 Sec. 28 Twp. 17 R. 4EWell No. 7 NovakHarwood Oil etal Company

Contractor

**COMPLETED**

SE SW

       Ft. from N. Line330 Ft. from S. Line330 Ft. from E. Line       Ft. from W. Line

NOVAK POOL

**SECTION PLAT**


Location       Rig up       

Drilling and Remarks:

*Wire 2403**5" @ 2405**Pump 164 P.D.**362 Bl.***RECORD**Cased        in.,        ft.Sand       Gas       Oil       Total Depth 2437**PRODUCTION**1st 24 hrs. Nat.       1st 24 hrs. after shot       Gas        Cu. Ft.Dry Hole       Abandoned       

Date

MAR 5 1941 19

S. J. LEWIS Scout

Misc. Small Maps

Cards

Tracing

France Map

Scarborough Map

Moody Map

Geological Dept.

Moody Flat Book