


Marion

FORM 51 5M 4-41 PETROL


Company Loriaux & Harrington

NORTH Lost Spring Pool.

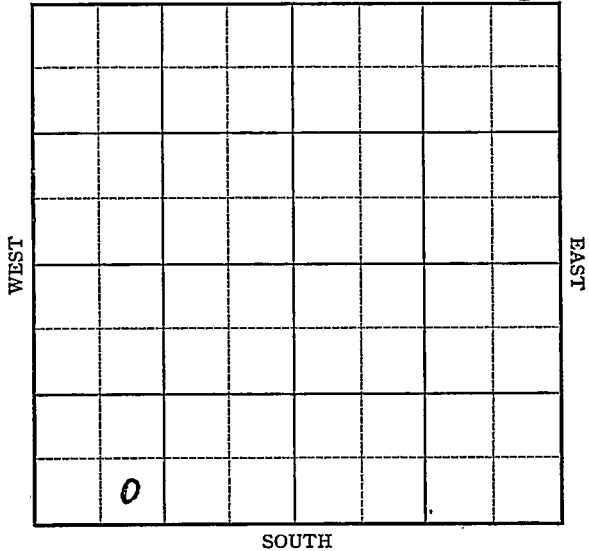

Sec. 28 Twp. 17 R. 4-EWell No. #5 Novak #4 FarmLoriaux & Harrington Company

(Lost Spring)

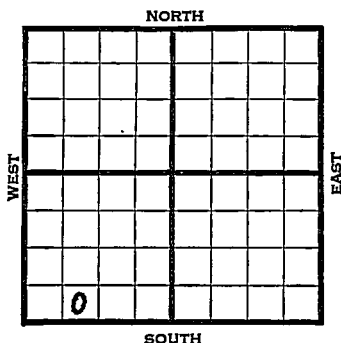 Ft. from N. Line330 Ft. from S. Line Ft. from E. Line990 Ft. from W. Line

1941	REPORT
8/27	Location
9/4	"
9/11	"
9/18	Spud.
9/25	12" - 97' Drlg. 890'
10/2	10" - 1490' Drlg. 1510'
10/9	8" - 1847' Drlg. 1980'
10/16	Drlg. 2335'
10/23	SD 2335'
10/30	"
11/6	Miss. 2326' 5" - 2399'
	T.D. 2419½' Potential 487 bbls
	on pump.
11/12	Miss. 2326'
	5" - 2399'
	T.D. 2419½'
	Potential 619 bbls., pump.
	36.7 Gravity
	COMPLETED

Map No. 26 Sec. 28 Twp. 17 R. 4EWell No. 3 NovakLoriaux & Harrington

Company

FIRST REPORT

Contractor

SECTION PLAT

SE SW SW

Ft. from N. Line

330 Ft. from S. Line

Ft. from E. Line

990 Ft. from W. Line

LOST SPRING POOL

Location X

Rig up

Drilling and Remarks:

RECORD

Cased _____ in., _____ ft.

Sand _____

Gas _____

Oil _____

Total Depth _____

PRODUCTION

1st 24 hrs. Nat. _____

1st 24 hrs. after shot _____

Gas _____ Cu. Ft.

Dry Hole _____

Abandoned _____

Date

AUG 27 1941

19

S. J. LEWIS

Scout

Map No. 26 Sec. 28 Twp. 17 R. 4EWell No. 4 NovakLoriaux & Harrington CompanyCORRECTION Contractor

SE SW SW

SECTION PLAT

 Ft. from N. Line330 Ft. from S. Line Ft. from E. Line990 Ft. from W. Line

LOST SPRING POOL

RECORD

Location Cased in., ft.Rig up Sand

Drilling and Remarks:

Gas Reported as # 42Oil Total Depth

PRODUCTION

1st 24 hrs. Nat. 1st 24 hrs. after shot Gas Cu. Ft.Dry Hole Abandoned

Date

SEP 3 1941 19S. J. LEWIS Scout

Marion

KANSAS

Map No. K-26 Sec. 28 Twp. 17 R. 4EWell No. 4 NovakLoriaux & Harrington CompanyCOMPLETED

Contractor

SE SW SW

SECTION PLAT

 Ft. from N. Line330 Ft. from S. Line Ft. from E. Line990 Ft. from W. Line

LOST SPRING POOL

Location Rig up

Drilling and Remarks:

*Miss 2326**5" @ 2399'**Pump 619 P28**36 7/8*

RECORD

Cased in., ft.Sand Gas Oil Total Depth 2419 1/2

PRODUCTION

1st 24 hrs. Nat. 1st 24 hrs. after shot Gas Cu. Ft.Dry Hole Abandoned

Date

NOV 12 1941 19

S. J. LEWIS Scout