


Section 28 Township 17 Range 4E


Well No. #1 Novak "A"

Company Paul Amos & Young

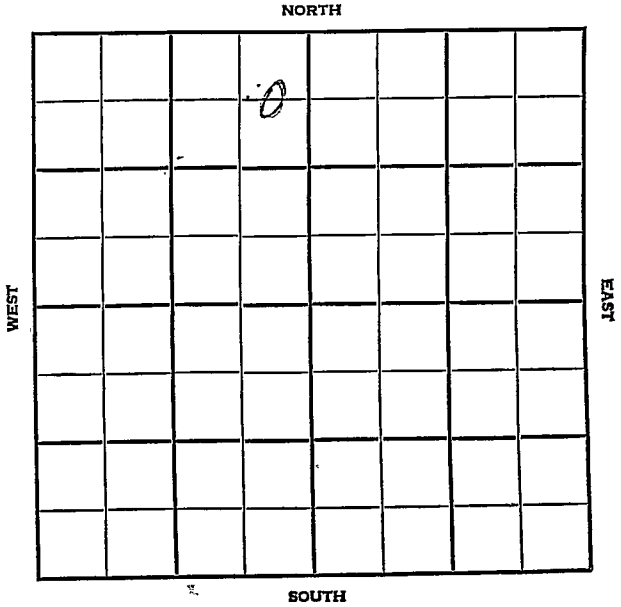

County Marion Elev. \_\_\_\_\_  
 Sec. 28 Twp. 17 Rge. 4E  
 Company Paul Amos & Young  
 FarmName Novak No. 3

TOPS	DEPTH	LOG	DATUM	Loc. in Sec.
Anh.				C E/2 NE NW
Tp.				Twin
H.				
Tr.				
Dg.				
Bl.				
L.				Geol. _____
K.C.				Contr. _____
B.K.C.				Berentz Drlg.
Ce.				
C.				Pool
M.				Lost Springs
M.				
K.				
Mz.				
Me.				
V.				
S.				
S.				
A.				
R.				
PE.				
G.				
T.D.				

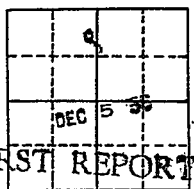

Date Comm. 11-29-56  
8" @ 135/ w/100, Drlg. 1210

*[Handwritten signature]*

Co.  
No.  
Sec.  
T.  
R.

# CORRECTION

FORM 513 SUNRAY

County Marion Elev. 1479 DF  
 Sec. 28 Twp. 17 Rge. 4B  
 Company Paul Amos & Young  
 Farm Name Novak "A" No. 21

TOPS	DEPTH	LOG	DATUM	Loc. in Sec.			
Anh.				C E/2 NE NW			
Tp.				Twin			
H.				500 FNC 330 FEL of NW 4			
Tr.				Geol.			
Dg.				Contr.			
Bl.				Berentz Drlg.			
L.				Pool			
K.C.				Lost Springs			
B.K.C.				<table border="1" style="width: 100%; height: 100%; border-collapse: collapse;"> <tr><td style="text-align: center;">o</td></tr> <tr><td style="text-align: center;">JAN 2 '57</td></tr> <tr><td style="text-align: center;">COMPLETE</td></tr> </table>	o	JAN 2 '57	COMPLETE
o							
JAN 2 '57							
COMPLETE							
Ce.							
C.	2382						
M.							
M.							
K.							
Nz.							
Mo.							
V.							
S.							
S.							
A.							
R.							
Pe.							
G.							
TD.	2390						

Date Comm. 11-29-56  
8" @ 135/ w/100; Drlg. 1210 DEC 12 '56  
4 1/2 @ 2389 DEC 19 '56 DD 24.27  
S.O. 2408-16 F10C DEC 26 '56 P. 2d.  
JAN 2 '57 est. P. 10 Bopd +  
50 Bwpd.