


Section 28 Township 17 Range 4EWell No. #1 Schiek BernhardtCompany Schnoover Bramlidge

NORTH

(Bernhardt)

WEST

EAST

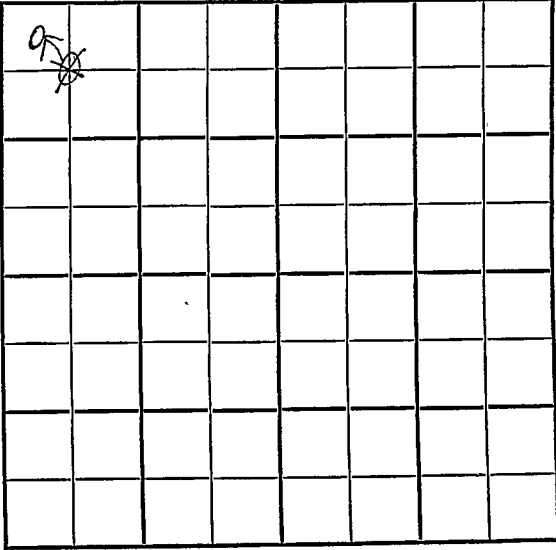

SOUTH

County Marion Elev. _____
Sec. 28 Twp. 17 Rge. 4E
Company Schnoover
Farm Name Schick No. 1

TOPS	DEPTH	LOG	DATUM
Anh.			
Tp.			
H.			
Tr.			
Dg.			
BL.			
L.			
K.C.			
B.K.C.			
Ce.			
C.			
M.			
M.			
K.			
Mz.			
Me.			
V.			
S.			
S.			
A.			
R.			
Pe.			
G.			
T.D.			

Loc. in Sec. C NW NW
Geol. _____
Contr. _____
Slusser Tools
Pool _____
Lost Springs

0		

NOV 28 '56
FIRST REPORT

Date Comm. 11-24-56
8" @ 127, drlg. 1650

CORRECTION

FORM 513 SUNRAY

County	Marion	Elev.	14.89
Sec.	28	Twp.	17
		Rge.	4E
Company	Schnoover Bramlidge		
Farm Name	Senick Berhardt		No. 1

TOPS /	DEPTH	LOG	DATUM	Log-in-Sec.
Anh.				G NA NW NW
Tr.				
H.				
Tr.				
Dg.				
BL.				
L.				Geol.
K.C.				Contr.
B.K.C.				Slusser Tools
Ce.				
C.				Pool
M.	2387			Lost Springs
M.				
K.				
Mz.				
Ma.				
V.				
S.				
S.				
A.				
R.				
Pe.				
G.				
TD.	2390			

Date Comm. 11-24-56

8" @ 127, drlg. 1650 DEC 5 '56 4 1/2

2389/40 DD 2411 TD 100'

oil + 100' wh 12 hrs DEC 12 '56

DD 2418 IB 13 60 + 12 Gwph

S.D. DEC 19 '56 POP DEC 25 '56 JAN 2 '57 ✓

JAN 9 " JAN 1 " JAN 23 '57 ✓ JAN 30 '57

est P. 12 Bopd + 20 Bwph