


Section 28 Township 17 Range 5E

Well No. #1 Novak

Company Basco Drlg.

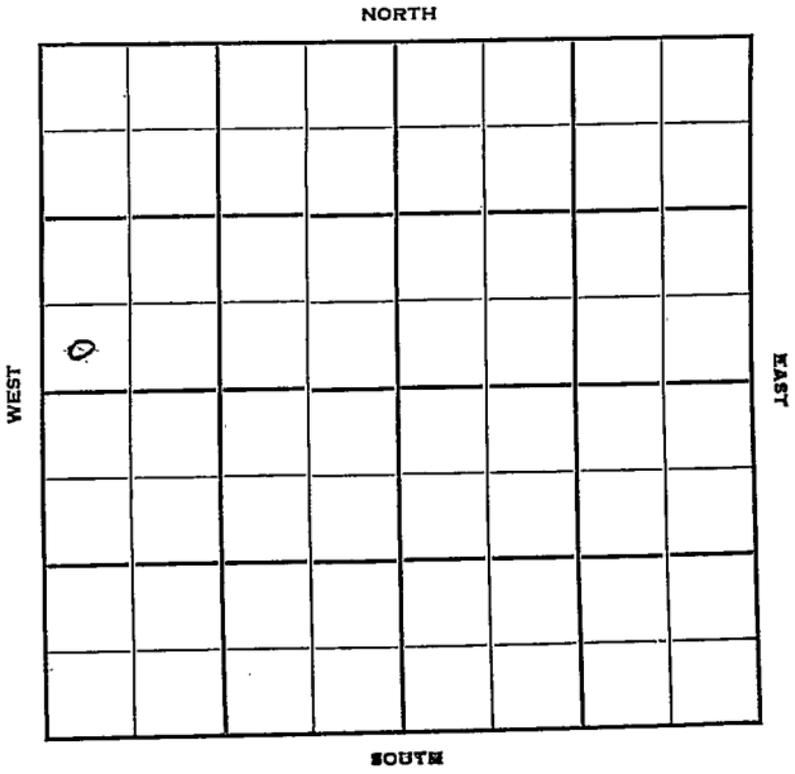

KANSAS

Morris

Sec. 26 28 Twp. 17 R. 5-E

Well No. #1 Novak Farm

Basco Drlg. Company

Basco Drlg. Contractor

Wildcat


_____ Ft. from N. Line

330 Ft. from S. Line

_____ Ft. from E. Line

330 Ft. from W. Line

SW SW NW

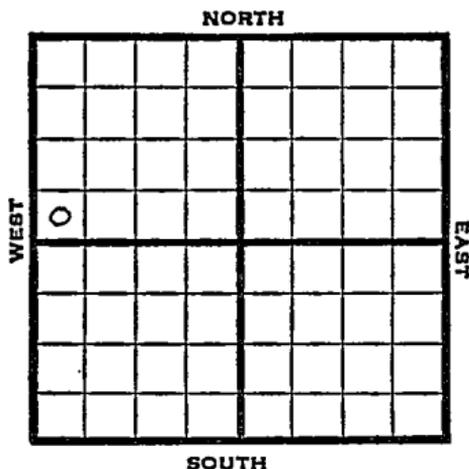

1950 Elev 1487

REPORT

7/26 Location

8/30 8 5/8" @ 168

Cong 2251-57 Miss 2257-96

Kinderhook 2320

TD 2370

D&A

Map No. _____ Sec. 28 Twp. 17 R. 5E

Well No. 1 Novak

Basco Drlg. _____ Company

Basco Drlg. _____ Contractor

SW SW NW


_____ Ft. from N. Line

330 Ft. from S. Line

_____ Ft. from E. Line

330 Ft. from W. Line

SECTION PLAT

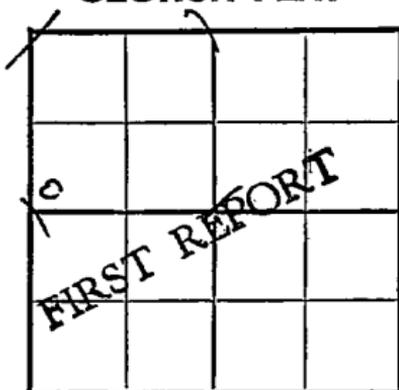

Morris County

Location x

Rig up _____

Drilling and Remarks:

RECORD

Cased _____ in., _____ ft.

Sand _____

Gas _____

Oil _____

Total Depth _____

PRODUCTION

1st 24 hrs. Nat. _____

1st 24 hrs. after shot _____

Gas _____ Cu. Ft.

Dry Hole _____

Abandoned _____

Date

JUL 26 1950 19

J. E. TYRA Scout

County Morris State Kansas

Sec. 28 (Blk.) 17 (Sur.) 5E Map No.

Operator Basco Drlg.

Well No. 1 Farm Novak

Elev. 1487 Location SW SW NW

0					

ABANDONED

330 Ft. From S Line NW

330 Ft. From W Line Quarter

Ist. Report

Completion AUG 30 1950

Remarks

Spudding Date 8-15-50

Drlg. Data D & A TD 2370

8 5/8" @ 168 Cong. 2251-57 Miss. 2257-96

Hinderhook 2320 TD 2370 D & A