


Section 28 Township 17 Range 9E

Well No. #1 P.R. Loy

Company Fred Drolte etal (Amarillo, Tex.)

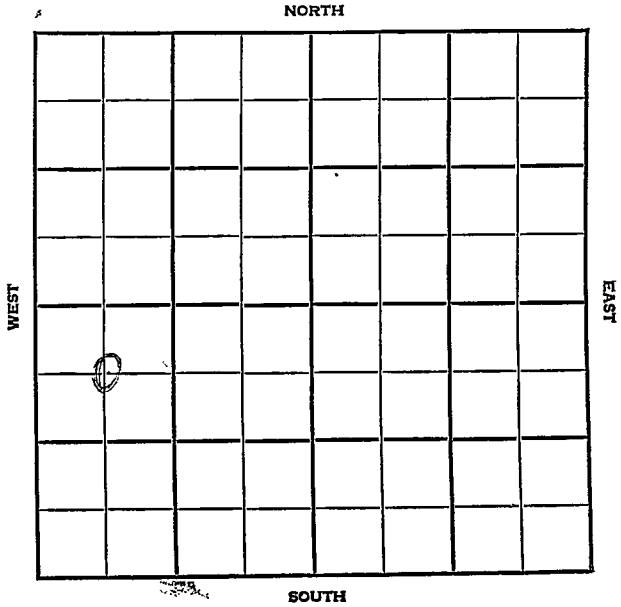

No County Map

County Morris Elev. 1303 DF
 Sec. 28 Twp. 17 Rge. 9E
 Company Fred Drolte etal (Amarillo, Tex)
 Farm Name P. R. Loy No. 1

TOPS	DEPTH	LOG	DATUM	Loc. in Sec.
Anh.				C NW SW
Tr.				
H.				
Tr.				
Dg.				
Bl.				
L.	<u>1454</u>			
K.C.	<u>Burg sd 2425</u>	<u>2445</u>		Geol.
B.K.C.				Contr.
Ce.				
C.			<u>2466</u>	White & Ellis
M.	<u>2443</u>	<u>2466</u>	<u>1303</u>	Tools
M.			<u>1163</u>	Pool
K.	<u>2798</u>	<u>2800</u>		
Mz.	<u>HURT 2923</u>	<u>2925</u>		Wildcat
Ma.		<u>2970</u>		
V.	<u>3026</u>	<u>3036</u>		
S.	<u>St Pet. 3124</u>	<u>3141</u>		
S.				<div style="border: 1px solid black; padding: 5px; text-align: center;"> ABANDONED DEC 5 '56 </div>
A.	<u>3189</u>	<u>3188</u>		
R.				
PE				
G.				
TD.	<u>3222</u>	<u>3232</u>		(will open if p. se)

Date Commspd. 11-8-56 Carter (ACP)
 8" @ 158 w/100, WORT NOV 21 '56 11630

NOV 28 '56 11634 DEC 5 '56
DST 3110-31 30" 825' 501p w/g
FP 60-410 BHP 1040/20

2423
2443
480

DEO.

Co.

Loc

No.

Sec.

T.

R.