

Well No.

Sec.

Twp.

R.

Farm

Company

NORTH

WEST

EAST

SOUTH

Location

Drilling Remarks

Rig Up

Drilling Remarks

RECORD

Cased_____ in. _____ ft.

Sand_____.

Gas

Oil

Total Depth

PRODUCTION

1st 24 hrs. Nat.

1st 24 hrs. after shot.....

Gas cu. ft.

Dry Hole _____

Abandoned.....


Usage
Map No. KANSAS Sec. 28 Twp. 17 R. 15^E
Well No. 1 - Bartee Farm
Loebel et al Company

 Ft. from N. Line

660 Ft. from S. Line

 Ft. from E. Line

660 Ft. from W. Line

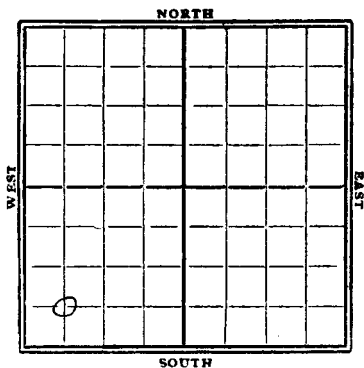

929

Date	REPORT
3/20	Location
3/27	—
4/3	—
4/10	—
4/17	Spdy.
4/24	—
4/30	Spud 250'
5/8	No report
5/15	—
5/22	Drly 1150'
5/29	SD 1190'
6/5	—
6/12	—
6/19	—
6/26	—
7/2	—
7/10	—
7/17	—
7/24	—
7/31	—
8/7	—
8/14	Drly 1215'

8/21 - wery 1215

8/28 - top line 1646

uly 1731

9/4 —

9/11 - Top line 1646-2076

Side line 2150-2230'

T.D. 2240'

HFW

Dry & Abandoned

Map No. **KANSAS** Sec. *28* Twp. *17* R. *15*
 Well No. *1* *Barter*
Goebel *et al* Company

Contractor

FIRST REPORTS

Ft. from N. Line

660 Ft. from S. Line

Ft. from E. Line

660 Ft. from W. Line

SECTION PLAT

0			

Location ☒

Rig up

Drilling and Remarks:

RECORD

Cased _____ in., _____ ft.

Sand _____

Gas _____

Oil _____

Total Depth _____

PRODUCTION

1st 24 hrs. Nat. _____

1st 24 hrs. after shot _____

Gas _____ Cu. Ft.

Dry Hole _____

Abandoned _____

Date

MAR 20 1929

CHAS. L. SHERWOOD

192

Scout

77 KANSAS

Map No. _____ Sec. 28 Twp. 17 R. 15

Well No. 1 Barter

Scheef et al

Company

Contractor

COMPLETE

SECTION PLAT

0			

_____Ft. from N. Line

660 _____Ft. from S. Line

_____Ft. from E. Line

660 _____Ft. from W. Line

ABANDONED

Location _____

Rig up _____

Drilling and Remarks:

Top line 1046-2076

Side line 2150-2230

H. W.

RECORD

Cased _____ in., _____ ft.

Sand _____

Gas _____

Oil _____

Total Depth 2240

PRODUCTION

1st 24 hrs. Nat. _____

1st 24 hrs. after shot _____

Gas _____ Cu. Ft.

Dry Hole ☒Abandoned ☒

Date

SEP 11 1929

192

CHAS. L. SHERWOOD

Scout