

KANSAS

Form 51-5M-7-40-Palace


Marion

Section 29 Township 17 Range 4-E

Well No. #2 Neuwirth

Company Ward McGinnis

NORTH Novak Pool

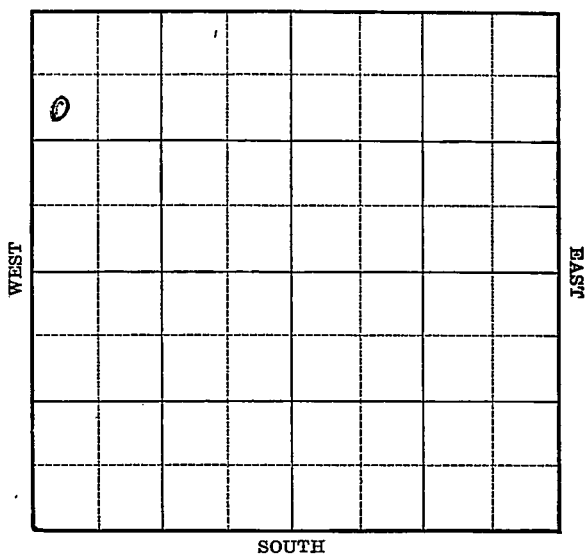

Map No. 26 Sec. 29 Twp. 17 R. 4EWell No. 2 Neuwirth

Ward McGinnis

Company

Contractor

ABANDONED

SW NW NW

990 Ft. from N. Line Ft. from S. Line Ft. from E. Line330 Ft. from W. Line

NOVAK POOL

SECTION PLAT

e			

Location Rig up

Drilling and Remarks:

*Miss 2512.**6" @ 2512**No show*

RECORD

Cased in., ft.Sand Gas Oil Total Depth 2620

PRODUCTION

1st 24 hrs. Nat. 1st 24 hrs. after shot Gas Cu. Ft.Dry Hole Abandoned

Date

DEC 4 1940₁₉

S. J. LEWIS Scout