

KANSAS

Marion

Form 51—5M—7-39—Palace

Section 29 Township 17 Range 4-E


Well No. #1 Nybert

Company Ward McGinnis

Novak Pool

NORTH

WEST

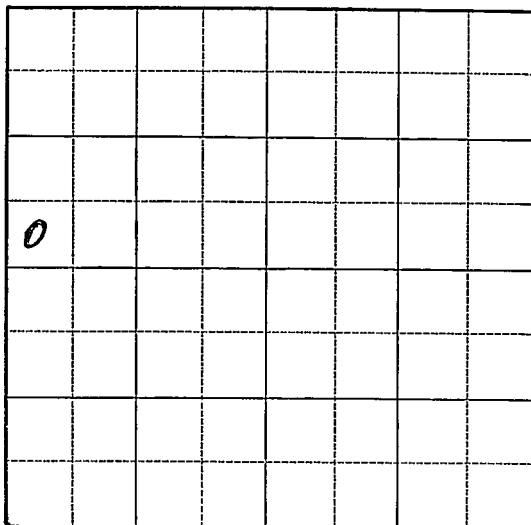

EAST

SOUTH

KANSAS

Marion

Sec. 29 Twp. 17 R. 4-EWell No. #1 Nybert FarmWard McGinnis


Company

(Novak)

 Ft. from N. Line330 Ft. from S. Line Ft. from E. Line330 Ft. from W. Line

Elev. 1473 Est Df

1471 Gr

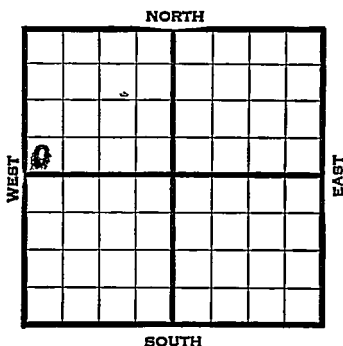

1940	REPORT
5/8	Location
5/16	"
5/23	Cellar.
5/29	Spud.
6/6	12" - 111' 10" - 835'
	Drlg. 1360'
6/13	8" - 1680' Drlg. 1695'
6/20	1770' U.R. 8".
6/27	8" - 1830' K.C. 1860'
	Drlg. 2265'
7/3	Miss. 2400-04' T.D. 6" - 2404'
	P.B.P.
7/11	S.O. 2440-2459'
7/18	5" - 2475' T.D. 2483' WOC.
7/25	" " " "
8/2	" " " "
8/8	Drlg. 2490'
	OVER

1940
8/14

Miss. 2400'
6" - 2404'
5" - 2475'
T.D. 2491'
Water.

ABANDONED

Marion KANSAS

Map No. 26 Sec. 29 Twp. 17 R. 4EWell No. 1 Nybert

Ward McGinnis _____ Company

Contractor


FIRST REPORT

SW NW

Ft. from N. Line330
Ft. from S. Line_____
Ft. from E. Line330
Ft. from W. Line

Novak Pool

SECTION PLAT

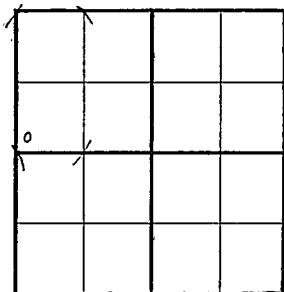Location X

Rig up _____

Drilling and Remarks: _____

RECORD

Cased _____ in., _____ ft.

Sand _____

Gas _____

Oil _____

Total Depth _____

PRODUCTION

1st 24 hrs. Nat. _____

1st 24 hrs. after shot _____

Gas _____ Cu. Ft.

Dry Hole _____

Abandoned _____

Date

MAY 8 1940 19

S. J. LEWIS Scout

Misc Small Maps.....
Cards.....
Tracing.....
France Map.....
Scarborough Map X.....
Moody Map.....
Geological Dept.
Moody Plat Book

Map No. 26 Sec. 29 Twp. 17 R. 4EWell No. 1 NybertWard McGinnis Company

Contractor

ABANDONED

SW NW

 Ft. from N. Line330 Ft. from S. Line Ft. from E. Line330 Ft. from W. Line

NOVAK POOL

SECTION PLAT

6			

Location Rig up

Drilling and Remarks:

*Mis 2400**6" @ 2404**5' @ 2475**Water.*

RECORD

Cased in., ft.Sand Gas Oil Total Depth 2491

PRODUCTION

1st 24 hrs. Nat. 1st 24 hrs. after shot Gas Cu. Ft.Dry Hole Abandoned

Date

AUG 14 1940 19S. J. LEWIS Scout

no.

[Handwritten scribbles and lines]

Misc Small Maps	<i>[Signature]</i>
Cards.....	<i>[Signature]</i>
Tracing.....	<i>[Signature]</i>
France Map.....	<i>[Signature]</i>
Scarborough Map.....	<i>[Signature]</i>
Moody Map.....	<i>[Signature]</i>
Geological Dept.	
Moody Flat Book	