


Section 29 Township 17 Range 7EWell No. #1 B. V. CarpenterCompany Stanolind

NORTH

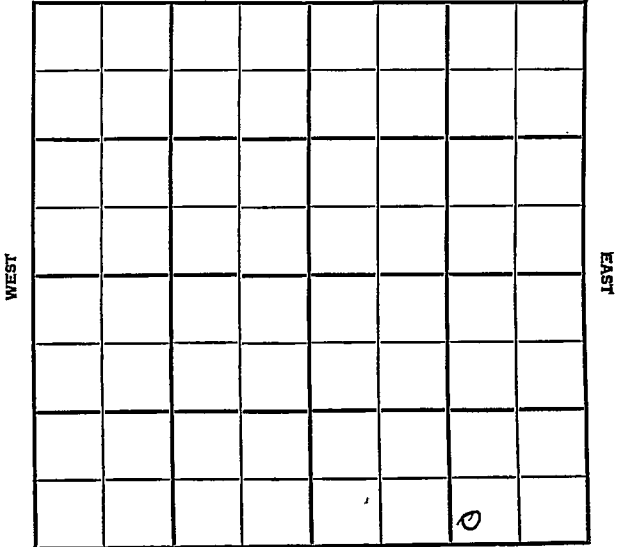

SOUTH

Morris

KANSAS

SEC.	TWP.	R.
29	17	7E

WELL NO.

1 B. V. Carpenter

FARM

COMPANY

Stanolind -

CONTRACTOR

G-M-R

Wildcat

Ft. from N. Line

100'


Ft. from S. Line

950'

Ft. from E. Line

Ft. from W. Line

SW SE SE

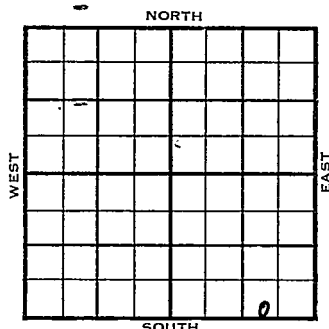

	ELEVATION	REPORT
1955	1486	
6/15	Location	
7/20	Comm 6-19-55	
	Anh Howard	834
	Tp	916
	H Dear Creek	1000
	Tr Oread	1189
	Dg Heeb	1224
	Bl Tor	1231
	L Ireland sd	1301
	Lans	1459
	KC	1563
	BKC	1802
	C	1986
	8 5/8" @ 200 DST 788-850	
	open 1/2 hr Rec 3' mud 0/20"	
	DST 901-50 open 45 min. Rec 90' mud	
	280# DST 1192-1210 open 1/2 hr	
	Rec 10' mud 350/20" DST 1246-1320	
	open 45 min. Rec 235' gassy mud	
	450/20" DST 1246-66 open 1/2 hr	
	Rec 15' mud 430/20" DST 2006-20	
	open 1/2 hr Rec 15' drlg	

1802
1486
316

1802

OVER

1955

7/20 mud 525/20" mud 525/20" DST
2065-3152 open 15 min. Rec 600' mud
650/20" DST 2020-45 open 20 min
Rec 990' sw 610/20"
5 1/2" @ 1700 CO 1668 -CO 1668
40/1602-12 1.37 bswph 5 hr
PB 1595 48/1574-86 B/15 gswph
500 A S /3 1/2 bswph PB 1380
49/1304-16 679 mcfg frac
2,864 mcfg open flow 2,339 mcfgpd
PB 1275 28/618-25 1 1/2 bswph
6 hr Comp shut in gas well 1,533
mcfgpd

COMPLETED

JUN 21 1955

Scout Cards	mmc
Land Small Map	
Land Wall Map	
Tracings	
France Map	
Pierce Map	
Misc.	

County Morris Elev. 1486
 Sec. 29 Twp. 17 Rge. 7E
 Company Stanolind
 Farm Name B. V. Carpenter No. 1

TOPS	DEPTH	LOG	DATUM	Loc. in Sec.
Anh. <u>Howard</u>		<u>834</u>		SW SE SE
Tp. <u>Deer Creek</u>		<u>916</u>		100' SL
H. <u>Deer Creek</u>		<u>1200</u>		950' EL
BKG. <u>KC</u>		<u>1503</u>	<u>77</u>	G-M-R
Ce. <u>RKC</u>		<u>1802</u>	<u>316</u>	
C.		<u>1986</u>	<u>500</u>	
M.				Pool
M.				Wildcat
K.				
Mz.				
Mq.				
V.				
S.				
S.				
A.				
R.				
PE.				
G.				
T.D.				

COMPLETE

Date Comm. 6-19-55 JUL 20 1955
8 5/8" @ 200 DST 788-850 open 1/2 hr.
Rec. " 3' mud 0/20" DST 901-50 open
45 min. Rec. 90' mud 280# DST 1192-
1210 open 1/2 hr. Rec. 10' mud 350/20"
DST 1246-1320 open 45 min. Rec. 235'
gassymud 450/20" DST 1246-66 open
1/2 hr. Rec. 15' mud 430/20"
DST 2006-20 open 1/2 hr. Rec. 15' drlg.

OVER

JUL 27 1955

Scout Cards	
Land Small Map	
Land Wall Map	
Tracings	
France Map	
Pierce Map	
Misc.	

mud 525/20" DST 2065-3152 open 15 min.
Rec. 600' mud 650/20" DST 2020-45
open 20 min: Rec. 990' SW 610/20"
5 1/2" @ 1700 60 1668 40/1602-12
1.37 bswph 5 hr. PB 1595. 48/1674-86
B/15 bswph 500 A S/3 1/2 bswph
PB 1380 49/.1304-16 679 mcfg frac
2,864 mcfg open flow 2,339 mcfgpd
PB 1275 28/618-25 1 1/2 bswph 6 hr.
Comp. Shut in gas well 1,533 mcfgpd