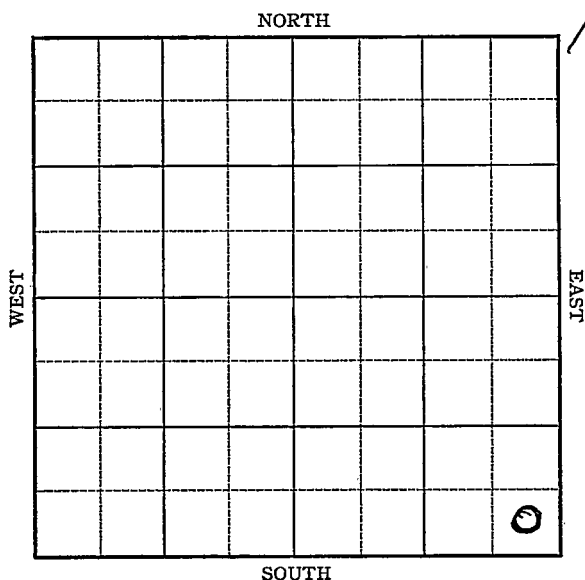


Form 51-5M 5-37 Petrol Marion

Section 3 Township 17 Range 4-EWell No. 1 - MartinCompany R. E. Youker

Map No. 26 Sec. 3 Twp. 17 R. 4E
Well No. 1-Martin
R.E. Youker Company
Contractor

FIRST REPORT

SECTION PLAT

			0

 Ft. from N. Line
330 Ft. from S. Line
330 Ft. from E. Line
 Ft. from W. Line

Location Rig up

Drilling and Remarks:

Mach

RECORD

Cased in., ft.Sand Gas Oil Total Depth

PRODUCTION

1st 24 hrs. Nat. 1st 24 hrs. after shot Gas Cu. Ft.Dry Hole Abandoned

Date

SEP 1 1937 19H. D. Hatfield Scout

Returned

Cards

Tracing

France Map

Scarborough Map

Moody Map

Scarborough Plat Book

Moody Plat Book

Marion KANSAS

Map No. 26 Sec. 3 Twp. 17 R. 4EWell No. I MartinR E Youker Company

Contractor

ABANDONED

SE/C

 Ft. from N. Line330 Ft. from S. Line330 Ft. from E. Line Ft. from W. Line

SECTION PLAT

			6

Location Rig up

Drilling and Remarks:

HFW

D & A

RECORD

5" Line in., 2309 ft.Sand Chat 2309Gas Oil Total Depth 2371

PRODUCTION

1st 24 hrs. Nat. 1st 24 hrs. after shot Gas Cu. Ft.Dry Hole Abandoned

Date

H. D. Hatfield

OCT 27 1937 19 Scout

RAH

Returned	
Cards	<i>Paul</i>
Tracing	<i>JM</i>
France Map	
See for 1st Map	<i>X</i>
Moody's	
Scarboro 1st Book	
Moody's Book	