

KANSAS


Marion

FORM 51 5M 1-42 PETROL

Section 3 Township 17 Range 4-E

Well No. ~~#3~~ ~~#4~~ #5 Martin

Company Yonker

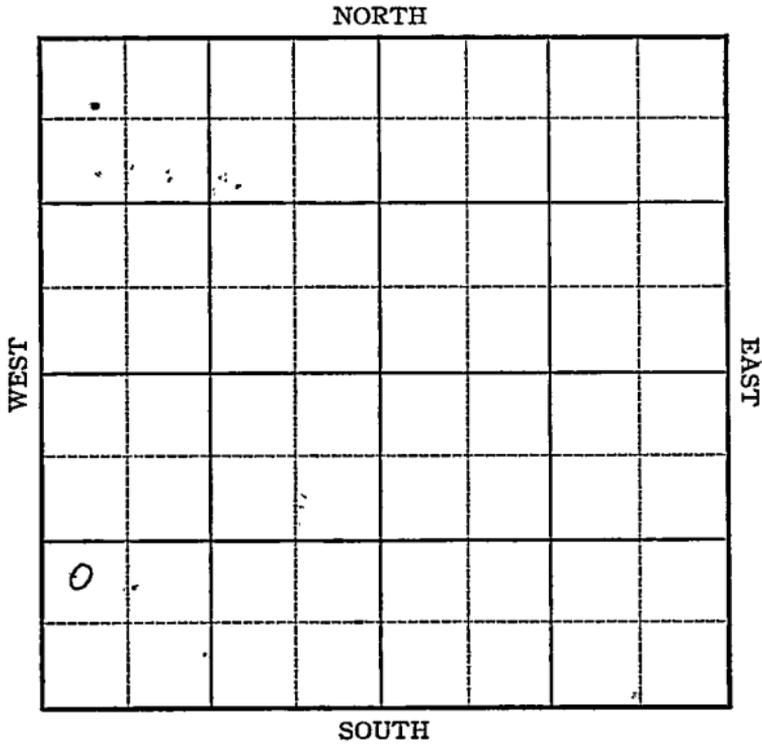

KANSAS

Marion

Sec. 3 Twp. 17 R. 4-E

Well No. #4 ~~#3~~ ~~#5~~ Martin Farm

Yonker Company


Lost Spring

_____ Ft. from N. Line

990 Ft. from S. Line

_____ Ft. from E. Line

330 Ft. from W. Line

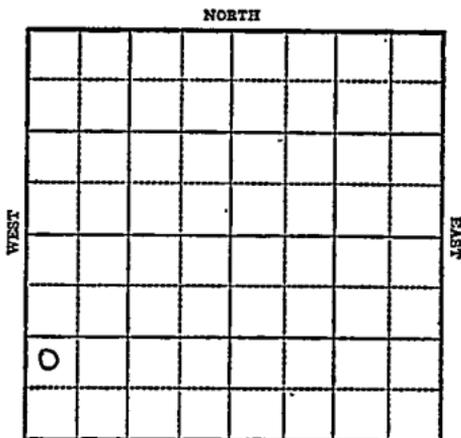

NW SW SW Elev. 1423 (sat)

1943 R E P O R T

- 2/17 100' Drlg.
- 2/24 100' SD
- 3/3 8" Casing set 133
Drlg. 2013
- 3/10 Miss 2311
5" Casing 2313'
TD 2339 RUST.
- 3/17 " " "
- 3/24 " " "
- 3/31 TD 2360 to drill deeper
- 4/7 " " " "
- 4/14 57' of 4" liner at 2360'
T.D. 2382-1600' oil 8 hrs.
- 4/21 T.D. 2391-1700' oil SW.
- 4/28 Miss. 2350
5" @ 2313'
T.D. 2391'
57' of 4" liner @ 2360'
Pump 15 oil plus 15 water.
Gravity 36.7

COMPLETED

KANSAS

Map No. 26 Sec. 3 Twp. 17 R. 4E

Well No. 4 Martin

Yonker Company

FIRST REPORT Contractor

NW SW SW

SECTION PLAT

_____ Ft. from N. Line

990 Ft. from S. Line

_____ Ft. from E. Line

330 Ft. from W. Line

LOST SPRING POOL

Location _____

Rig up _____

Drilling and Remarks:

100' Drlg.

RECORD

Cased _____ in., _____ ft.

Sand _____

Gas _____

Oil _____

Total Depth _____

PRODUCTION

1st 24 hrs. Nat. _____

1st 24 hrs. after shot _____

Gas _____ Cu. Ft.

Dry Hole _____

Abandoned _____

Date

FEB 17 1943 19

S. J. LEWIS Scout

no wall

Misc Small Maps	<i>One</i>
Cards	<i>Two</i>
Tracing	<i>MS</i>
France Map	<i>✓</i>
Scarborough Map	<i>X</i>
Moody Map	<i>X</i>
Geological Dept.	
Moody Flat Book	

Map No. ~~KANSAS~~ Sec. 3 Twp. 17 R. 4E

Well No. 3 Martin

Youker Company

CORRECTION Contractor

NW SW SW

_____ Ft. from N. Line

990 Ft. from S. Line

_____ Ft. from E. Line

330 Ft. from W. Line

SECTION PLAT

o			

LOST SPRINGS POOL

Location _____

Rig up _____

Drilling and Remarks:

Reported as

#4 Martin

RECORD

Cased _____ in., _____ ft.

Sand _____

Gas _____

Oil _____

Total Depth _____

PRODUCTION

1st 24 hrs. Nat. _____

1st 24 hrs. after shot _____

Gas _____ Cu. Ft.

Dry Hole _____

Abandoned _____

Date

MAR 3 1943 19

S. J. LEWIS Scout

no well

Misc Small Maps	<i>Ona</i>
Cards	<i>Boat</i>
Tracing	<i>MS</i>
France Map	<i>✓</i>
Scarborough Map	<i>X</i>
Moody Map	<i>✓</i>
Geological Dept.	
Moody + lat Book	

up wall

Misc Small Maps	<i>(In)</i>
Cards	<i>Boat</i>
Tracing	<i>MB</i>
France Map	<i>←</i>
Scarborough Map	<i>△</i>
Moody Map	<i>←</i>
Geological Dept.	
Moody Flat Book	

Handwritten scribble consisting of a series of connected loops and lines, possibly representing a signature or a stylized drawing.

Misc Small Maps	<i>Done</i>
Cards	<i>Done</i>
Tracing	<i>Done</i>
France Map	<i>X</i>
Scarborough Map	<i>X</i>
Moody Map	<i>X</i>
Geological Dept.	
Moody Flat Book	