


KANSAS , Marion

FORM 51 5M PETROL

Section 3 Township 17 Range 4E

Well No. 6 Martin

Company R. E. Youker

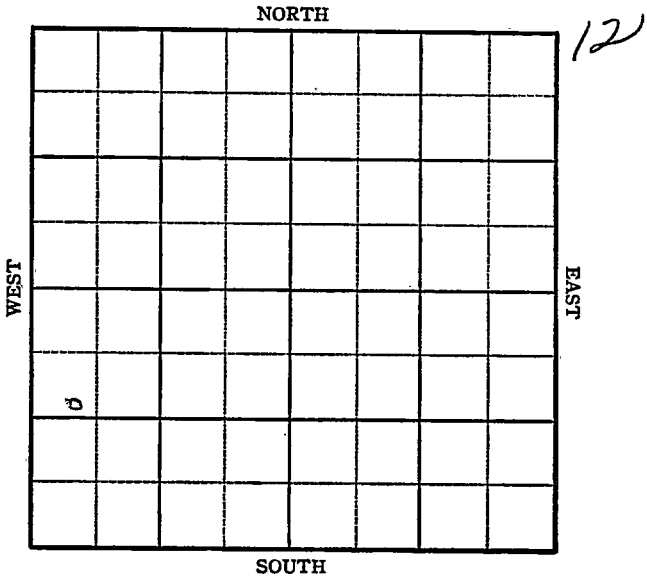


Sec. 3 Twp. 17 R. 4-E

Well No. #6 Martin Farm

R. E. Youker Company

NORTH

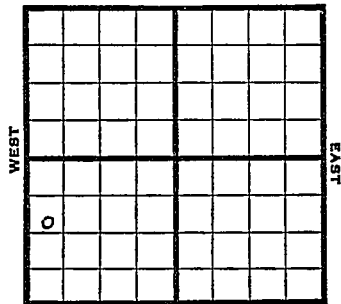

1130 Ft. from N. Line

_____ Ft. from S. Line

_____ Ft. from E. Line

400 Ft. from W. Line

SOUTH

SW NW SW

1945 Elev. 1435' REPORT

10/24 Rig
 10/31 "
 11/7 13" @ 114
 .. Drlg. 550
 11/14 Drlg. 1719'
 11/21 Drlg. 2000'
 11/28 10" @ 1035
 8" @ 1445
 6" @ 1735'
 Miss. 2320
 TD 2325
 5" @ 2320 WOC
 12/5 TD 2383
 1000' oil
 12/12 " "
 12/19 Miss. 2320
 5" @ 2320
 TD 2383
 Pump 200 Pot.
 Grav. 37.0

COMPLETED

KANSAS

Kansas Pool Name Lost Spring

Map No. 26 Sec. 3 Twp. 17 R. 4E

Well No. 6 Martin

R. E. Youker Company

FIRST REPORT

Contractor

SW NW SW

SECTION PLAT

1130 Ft. from N. Line

_____ Ft. from S. Line

_____ Ft. from E. Line

400 Ft. from W. Line

Marion County

Location _____

Rig up _____

Drilling and Remarks:
rig

RECORD

Cased _____ in., _____ ft.

Sand _____

Gas _____

Oil _____

Total Depth _____

PRODUCTION

1st 24 hrs. Nat. _____

1st 24 hrs. after shot _____

Gas _____ Cu. Ft.

Dry Hole _____

Abandoned _____

Date

OCT 24 1945 19

S. J. LEWIS Scout

no well

Misc. Small Maps	<i>OK</i>
Cards	<i>Books</i>
Tracing	<i>P/B</i>
France Map	_____
Scarborough Map	X
Pierce Map	_____
Geological Dept.	_____
Pierce Geological	_____

KANSAS Kansas Pool Name Lost Spring

Map No. X-26 Sec. 3 Twp. 17 R. 4E

Well No. 6 Martin

R. E. Youker Company

COMPLETED

Contractor

SW 1W SW

E11435
SECTION PLAT

1130 Ft. from N. Line

_____ Ft. from S. Line

_____ Ft. from E. Line

400 Ft. from W. Line

Marion County

Location _____

Rig up _____

Drilling and Remarks:

Misc 2320

5" @ 2320

Prod. 200 BT

87° S

RECORD

Cased _____ in., _____ ft.

Sand _____

Gas _____

Oil _____

Total Depth 2-283

PRODUCTION

1st 24 hrs. Nat. _____

1st 24 hrs. after shot _____

Gas _____ Cu. Ft.

Dry Hole _____

Abandoned _____

Date

DEC 19 1945 19

S. J. LEWIS Scout

no

1	<i>3</i>	<i>MA</i>
Cl. 3	<i>Parachy</i>	
Track 3	<i>214</i>	
France Map	<i>✓</i>	
Scarborough Map	<i>✓</i>	
Pierce Map	<i>✓</i>	
Geological Dept.		
Pierce Print Book		