


Morris

DX 78-1

Section 3 Township 17 Range 5E
Well No. #1 Ecklund
Company A.B. Johnston

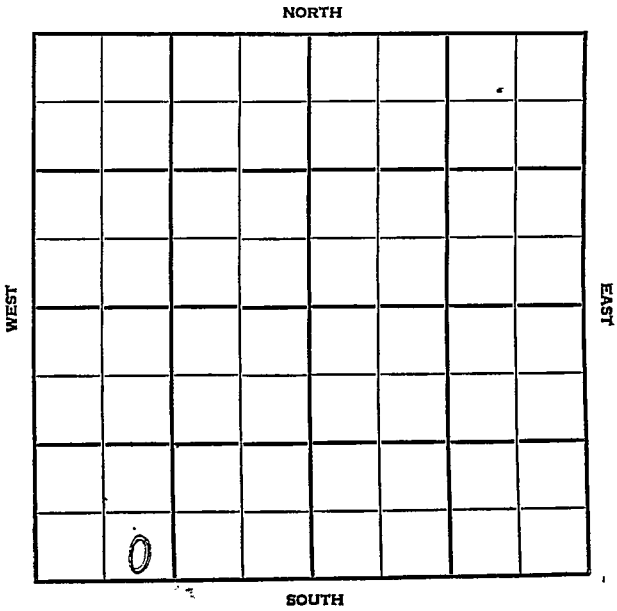

*No County Map*County **Morris**

Elev. _____

Sec. **3**Twp. **17**Rgs. **5E**Company **A.B. Johnston**Farm Name **Ecklund**No. **1**

TOPS

DEPTH

LOG

DATUM

Loc. in Sec. _____

Anh. _____

Tp. _____

H. _____

Tr. _____

Dg. _____

Bl. _____

L. _____

K.C. _____

B.K.C. _____

Ce. _____

C. _____

M. _____

M. _____

K. _____

Mz. _____

Mq. _____

V. _____

S. _____

S. _____

A. _____

R. _____

Pe. _____

G. _____

T.D. _____

SE SW SW

Geol. **Lee Cornell**

Contr. _____

Slusser Tools

Pool _____

FIRST REPORT

DEF 5

Date Comm **11-29-56****8 5/8" 197/150, Drlg. 2160**

Co.

No.

No.

Sec.

T.

R.

(No County Map)

County Morris Elev. est 1466
 Sec. 3 Twp. 17 Rge. 5E
 Company A.B. Johnston
 Farm Name Ecklund No. 1

TOPS	DEPTH	LOG	DATUM	Loc in Sec.
Anh.				SE SW SW
Tr.				
H.				
Tr.				
Dg.				
Bl.				
L.				Geol. Lee Cornell
K.C.				Contr.
B.K.C.				Slusser Tools
C.				Pool
M.	2214			
M. Base	2259			
K.				
Mz.				
Mo.				
V.				
S.				
S.				
A.				
R.				
Pe.				
G.				
TD.	2269			

ABANDONED
 DEC 13 '56

Date Comm. 11-29-56
8 5/8" 197/150. Dr. Lg. 2160 DEC 12 '56

D&A