

# KANSAS


FORM 51 5M BR1X

Marion County

Section 3 Township 17 Range 4E

Well No. #3 McNickol "B"

Company R. E. Youker

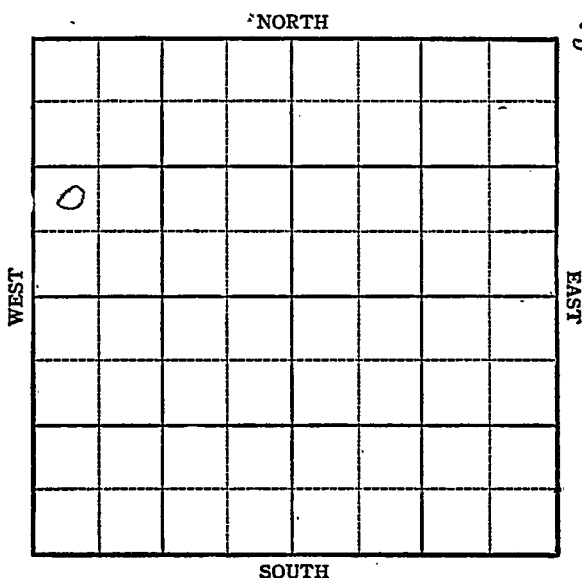

KANSAS Marion County

Sec. 3 Twp. 17 R. 4E

Well No. #3 McNickol "B" Farm

R. E. Youker Company

Lost Spring


           Ft. from N. Line

990 Ft. from S. Line

           Ft. from E. Line

330 Ft. from W. Line

NW SW NW Flow. 1427 SOUTH

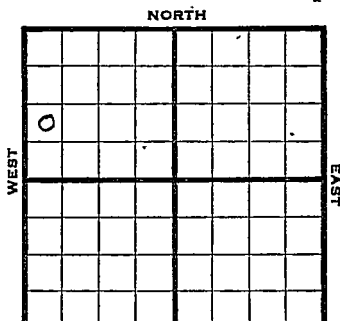

1944

R E P O R T

11/15 Cable rig  
11/24 18" @ 125 Drlg. 400  
11/29 Drlg. 1425  
12/6 10" @ 850'  
8" @ 1635'  
6" @ 1786'  
Drlg. 1864'  
12/14 Drlg. 2250'  
12/20 Miss 2320  
TD 2370'

ABANDONED

Pool Name Lost SpringMap No. 26 Sec. 13 Twp. 17 R. 4EWell No. 3 McNickol "B"R. E. Youker CompanyFIRST REPORT Contractor

NW SW NW

## SECTION PLAT

|   |  |  |  |
|---|--|--|--|
|   |  |  |  |
| o |  |  |  |
|   |  |  |  |
|   |  |  |  |

       Ft. from N. Line990 Ft. from S. Line       Ft. from E. Line330 Ft. from W. LineMarionLocation                     Rig up                     

Drilling and Remarks:

cable rig

## RECORD

Cased            in.,            ft.Sand                     Gas                     Oil                     Total Depth                     

## PRODUCTION

1st 24 hrs. Nat.                     1st 24 hrs. after shot                     Gas                      Cu. Ft.Dry Hole                     Abandoned                     

Date

NOV 15 1944 19S. J. LEWIS Scout

Pool Name Lost SpringMap No. 26 Sec. 3 Twp. 17 R. 4EWell No. 3 McNichol "B"R.E.Youker CompanyABANDONED Contractor

NW SW NW

## SECTION PLAT .

           Ft. from N. Line990 Ft. from S. Line           Ft. from E. Line330 Ft. from W. Line

|   |  |  |  |
|---|--|--|--|
|   |  |  |  |
| o |  |  |  |
|   |  |  |  |
|   |  |  |  |

MarionLocation                                 Rig up                                 

Drilling and Remarks:

Miss 2820.

## RECORD

Cased            in.,            ft.Sand                                 Gas                                 Oil                                 Total Depth 2370

## PRODUCTION

1st 24 hrs. Nat.                                 1st 24 hrs. after shot                                 Gas                                  Cu. Ft.Dry Hole                                 Abandoned                                 

Date

DEC 20 1944 19S. J. LEWIS Scout